
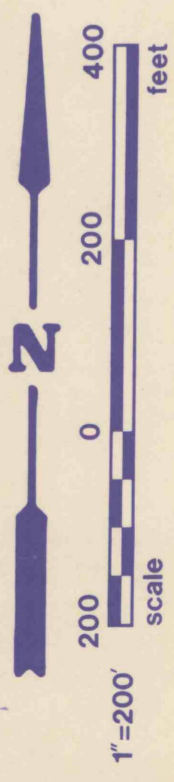


MATCH TO 17

POSTING DATE 12-1-1999  
FINAL MINE MAP

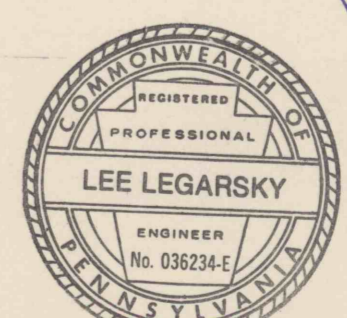

PLUMCEEK & SOUTH BEND TWPS.  
ARMSTRONG COUNTY

**EMILIE No. 1 & 2 MINE**  
**(UPPER FREEPORT COAL SEAM)**