




MATCH TO 7

MATCH TO 12

EMILIE No. 1 & 2 MINE  
 (UPPER FREEPORT COAL SEAM)  
 PLUMCECK & SOUTH BEND TOWNSHIPS,  
 ARMSTRONG COUNTY

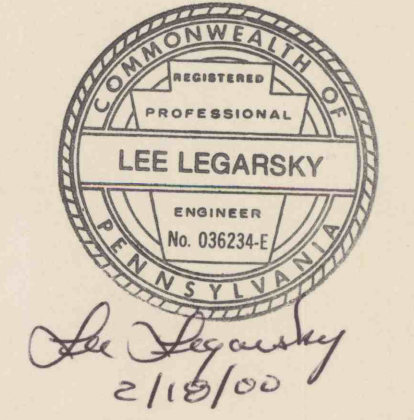

POSTING DATE 12-1-1999  
 FINAL MINE MAP

