




MATCH TO 7

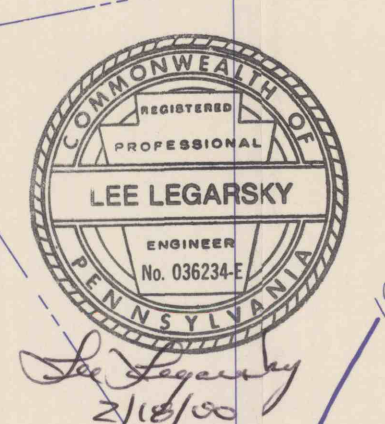

MATCH TO 10

PLUMCEEK & SOUTH BEND TOWNSHIPS, ARMSTRONG COUNTY

EMILIE No. 1 & 2 MINE
(UPPER FREEPORT COAL SEAM)

POSTING DATE 1-12-50
FINAL MINE MAP
SCALE
1"=200'
0 100 200 300 FEET