

**Stanford**  
 REGISTERED PROFESSIONAL ENGINEER  
 DOVERSPIKE BROS. COAL CO.  
 P.O. Box 271, Parkersburg, W. Va. 26101

**SUGARCAMP NO. 2**  
 SHEET No. 1 of 16 SCALE 1"=200'

**EXHIBIT "B"**

**LEGEND**


PERMIT AREA	POST 1966 DWELLINGS
UNDERGROUND WORKINGS	CEMETERIES
TOWNSHIP BOUNDARY	STRUCTURES
COUNTY BOUNDARY	MAJOR ELECTRIC LINES
TEST BOREHOLE	PIPELINES
CROP LINES	GAS WELLS
COAL CONTOURS	WATER WELLS
SURFACE WORKINGS	STREAMS
MINE OPENINGS, Not Sealed	LAKES or PONDS
MINE OPENINGS, Sealed	SPRING
PROPERTY LINES	WATER TREATMENT FACILITIES
PRE 1966 DWELLINGS	CONTIGUOUS PROPERTY

**LEGEND cont.**

WATER	6 MONTH PROJECTIONS
SUPPORT AREA	SUPPORT AREA (NO SECOND MINING)
CONTEMPLATED MINING	CONTEMPLATED MINING (2/15/93 TO 2/15/94)
COMPLETED MINING	COMPLETED MINING
SURVEY STATION	SURVEY STATION
GAS WELL BARRIER	GAS WELL BARRIER

**COMMONWEALTH OF PENNSYLVANIA**  
 REGISTERED PROFESSIONAL ENGINEER  
**JOSEPH P. KALYCHUK**  
 ENGINEER  
 No. 04233 E

*Joseph P. Kalychuk*  
 5-4-93

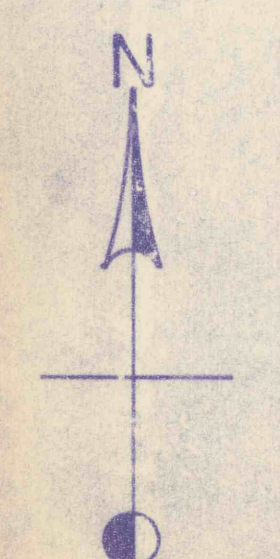

**DOVERSPIKE BROS. COAL CO.**  
**SUGARCAMP No. 2 MINE** SCALE: 1"=200'

DATE	INTAKE AIR	STOPPING W/ DOOR
	RETURN AIR	CHECK CURTAIN
	PRIMARY ESCAPEWAY	REGULATOR
	SECONDARY ESCAPEWAY	DOUBLE DOORS (Equip. doors)
	BELT LINE	OVERCAST
	B-E POINTS (Approved)	REGULATING CHECK
	B-E POINTS (Proposed)	
	STOPPING	

Survey is closed loop, Accuracy is 1:10000  
 Individuals responsible for information:  
 Mark Penny, Engineer & Larry Smith, Superintendent