

Stanford
 PORTER TWP., JEFFERSON CO.
Doverspike Bros. Coal Co.
 R. D. 4, Box 271, Punxsutawney, Pa. 15787

SUGARCAMP NO. 2
 SHEET No. 3 of 16 SCALE 1"=200'
 EXHIBIT "B"

LEGEND


PERMIT AREA	POST 1966 DWELLINGS
UNDERGROUND WORKINGS	CEMETERIES
TOWNSHIP BOUNDARY	STRUCTURES
COUNTY BOUNDARY	MAJOR ELECTRIC LINES
TEST BOREHOLE	PIPELINES
CROP LINES	GAS WELLS
COAL CONTOURS	WATER WELLS
SURFACE WORKINGS	STREAMS
MINE OPENINGS, Not Sealed	LAKES or PONDS
MINE OPENINGS, Sealed	SPRING
PROPERTY LINES	WATER TREATMENT FACILITIES
PRE 1966 DWELLINGS	CONTIGUOUS PROPERTY

LEGEND cont.

WATER	6 MONTH PROJECTIONS
SUPPORT AREA	CONTEMPLATED MINING
COMPLETED MINING	COMPLETED MINING
SURVEY STATION	GAS WELL BARRIER

COMMONWEALTH OF PENNSYLVANIA
 REGISTERED PROFESSIONAL ENGINEER
JOSEPH P. KALYNCZYK
 ENGINEER
 SEAL

Joseph P. Kalynczyk
 5-4-93
 SIGNATURE

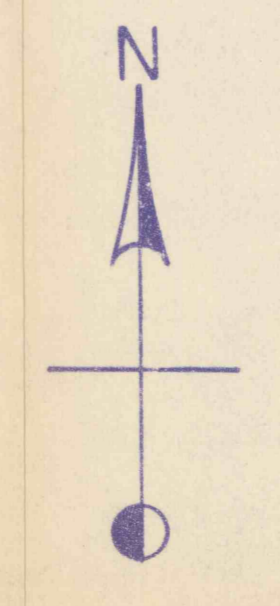

DOVERSPIKE BROS. COAL CO.
 SUGARCAMP No. 2 MINE SCALE: 1"=200'

DATE: _____

→ INTAKE AIR	⊞ STOPPING W/ DOOR
→ RETURN AIR	⊞ CHECK CURTAIN
→ PRIMARY ESCAPEWAY	⊞ REGULATOR
→ SECONDARY ESCAPEWAY	⊞ DOUBLE DOORS (Equip. doors)
→ BELT LINE	⊞ OVERCAST
△ B-E POINTS (Approved)	
△ B-E POINTS (Proposed)	
— STOPPING	

Survey is closed loop, Accuracy is 1:10000
 Individuals responsible for information:
 Mark Penny, Engineer & Larry Smith, Superintendent