




FINAL\_MINE MAP



**STANFORD**  
PORTER TWP., JEFFERSON CO.  
Doverspike Bros. Coal Co.  

**SUGARCAMP No. 2**

SHEET No. 10 of 16 SCALE 1"=200'


**EXHIBIT "B"**

**LEGEND**

Permit Area	Post 1966 Dwellings
Underground Workings	Cemeteries
Township Boundary	Structures
County Boundary	Major Electric Lines
Test Borehole	Pipelines
Crop Lines	Gas Wells
Surface Workings	Water Wells
Mine Openings, Not Sealed	Streams
Mine Openings, Sealed	Lakes or Ponds
Property Lines	Water Treatment Facilities
Pre 1966 Dwellings	Contiguous Property
Water Monitoring Point	Coal Contours
Background Sample	Spring
Dore #6 Mine	Minor Linear
Major Linear	

**LEGEND continued**

Water	6 Month Projections
Support Area	Support Area (No Sealed Mine)
Contemplated Mining	2/15/93 TO 2/15/94
Survey Station	
GAS WELL BARRIER	
PILLARS REMOVED	

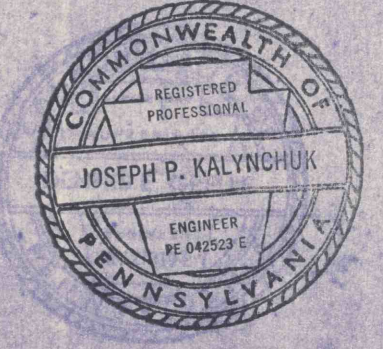

Joseph P. Kalyvichuk  
5-4-93



DOVERSPIKE BROS. COAL CO.  
SUGARCAMP No. 2 MINE

DATE: \_\_\_\_\_ SCALE: 1"=200'

INTAKE AIR	STOPPING W/ DOOR
RETURN AIR	CHECK CURTAIN
PRIMARY ESCAPEWAY	REGULATOR
SECONDARY ESCAPEWAY	DOUBLE DOORS (Equip. doors)
BELT LINE	OVERCAST
B-E POINTS (Approved)	
B-E POINTS (Proposed)	
STOPPING	

Survey is closed loop. Accuracy is 1:10000  
Individuals responsible for information:  
Mark Penny, Engineer & Larry Smith, Superintendent