



N 310,000
N 309,000
N 308,000
N 307,000
N 306,000
E 1,645,000
E 1,646,000
E 1,647,000
E 1,648,000
E 1,649,000
E 1,650,000
E 1,651,000

FINAL MINE MAP

CMAP No. 33911301




Doverspike Bros. Coal Co.
R.D. #4, Box 271, Punxsutawney, PA 15767
McCalmont, Oliver & Young Twp., Jefferson County

CLUTCH RUN MINE

SCALE: 1" = 200'
SHEET 3 of 6

MODULE 19.5

<ul style="list-style-type: none"> PERMIT AREA PROPERTY LINES PROPERTY OWNERS CONT. PROPERTY OWNERS PRE-66 DWELLINGS DWELLINGS, STRUCTURES PUBLIC BUILDINGS LK-1480 L.K. GOAL CONTOURS L.K. GOAL OUTCROP 	<ul style="list-style-type: none"> GAS LINE GAS WELL WATER WELL SPRING DRILL HOLE IMPOUNDMENT CEMETERY MINE OPENINGS, NOT SEALED 	<ul style="list-style-type: none"> MINE OPENINGS, SEALED STREAMS SURVEY STATION SUPPORT AREA (No Second Mining) IMPOUNDED WATER (In Mine) CONTEMPLATED MINING 8/1/94 TO 2/1/95 6 MONTH PROJECTIONS GAS WELL BARRIER (No Mining Within Barrier Unless Approved)
---	--	--

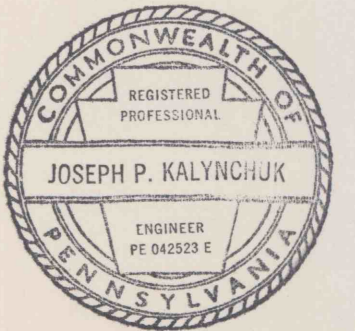

Joseph P. Kalywchuk
SIGNATURE

11-3-94
DATE