



MAR 28 2002



Subsidence Legend  
M.A.P. No. 3284322

Contemplated Mining	From	To
Previous Six Month's Mining	Limits of Mining Line	
Mining Completed	Subsidence Permit Line	
	Subsidence Support Area	


NOTE: All Coal Lands To Be Mined Are Within The Lower Freeport Coal Seam And Are Owned Solely By PENN CENTRAL CORPORATION.

FINAL MAP 2-18-02

Six Months Projection Map  
EXHIBIT 19.5

PREPARED FOR  
**RAYNE ENERGY, INC.**

**RAYNE NO. 1 MINE**  
LOWER FREEPORT COAL SEAM  
SITUATE  
PINE TOWNSHIP INDIANA COUNTY,  
PENNSYLVANIA

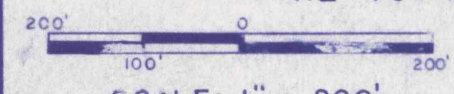

R.D.1 Central City, PA 15926  
(814) 754-8477  
Musser Engineering Inc.

Match to 5 of 6