

LEGEND

FEDERAL VENTILLATION SUBMITTAL 4/15/90

REVIEW NO. 23

DYNAMIC RECOVERY INC.



PITT GAS MINE

Jefferson Twp. Greene County


Pennsylvania

M.S.H.A. I.D. No. 36-06478

PITTSBURGH SEAM

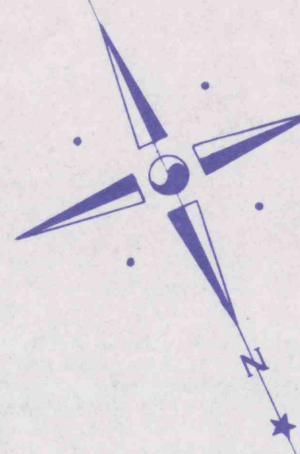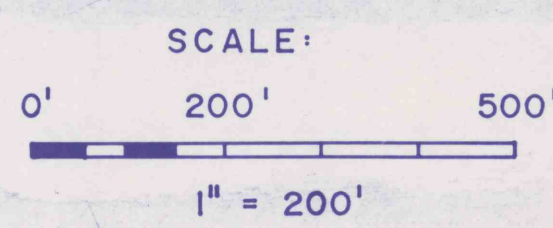

- INTAKE AIR
- RETURN AIR
- PERMANENT STOPPING
- REGULATOR
- DOOR
- OVERCAST
- UNDERCAST
- PROJECTION
- TRACK ESCP
- BELT ESCP
- SLASH REGULATOR
- CANVAS CHECK
- PROPOSED SEAL PS
- FRAME CHECK
- PILLARED AREA
- PERMIT BOUNDARY
- BODIES OF WATER (SURFACE)

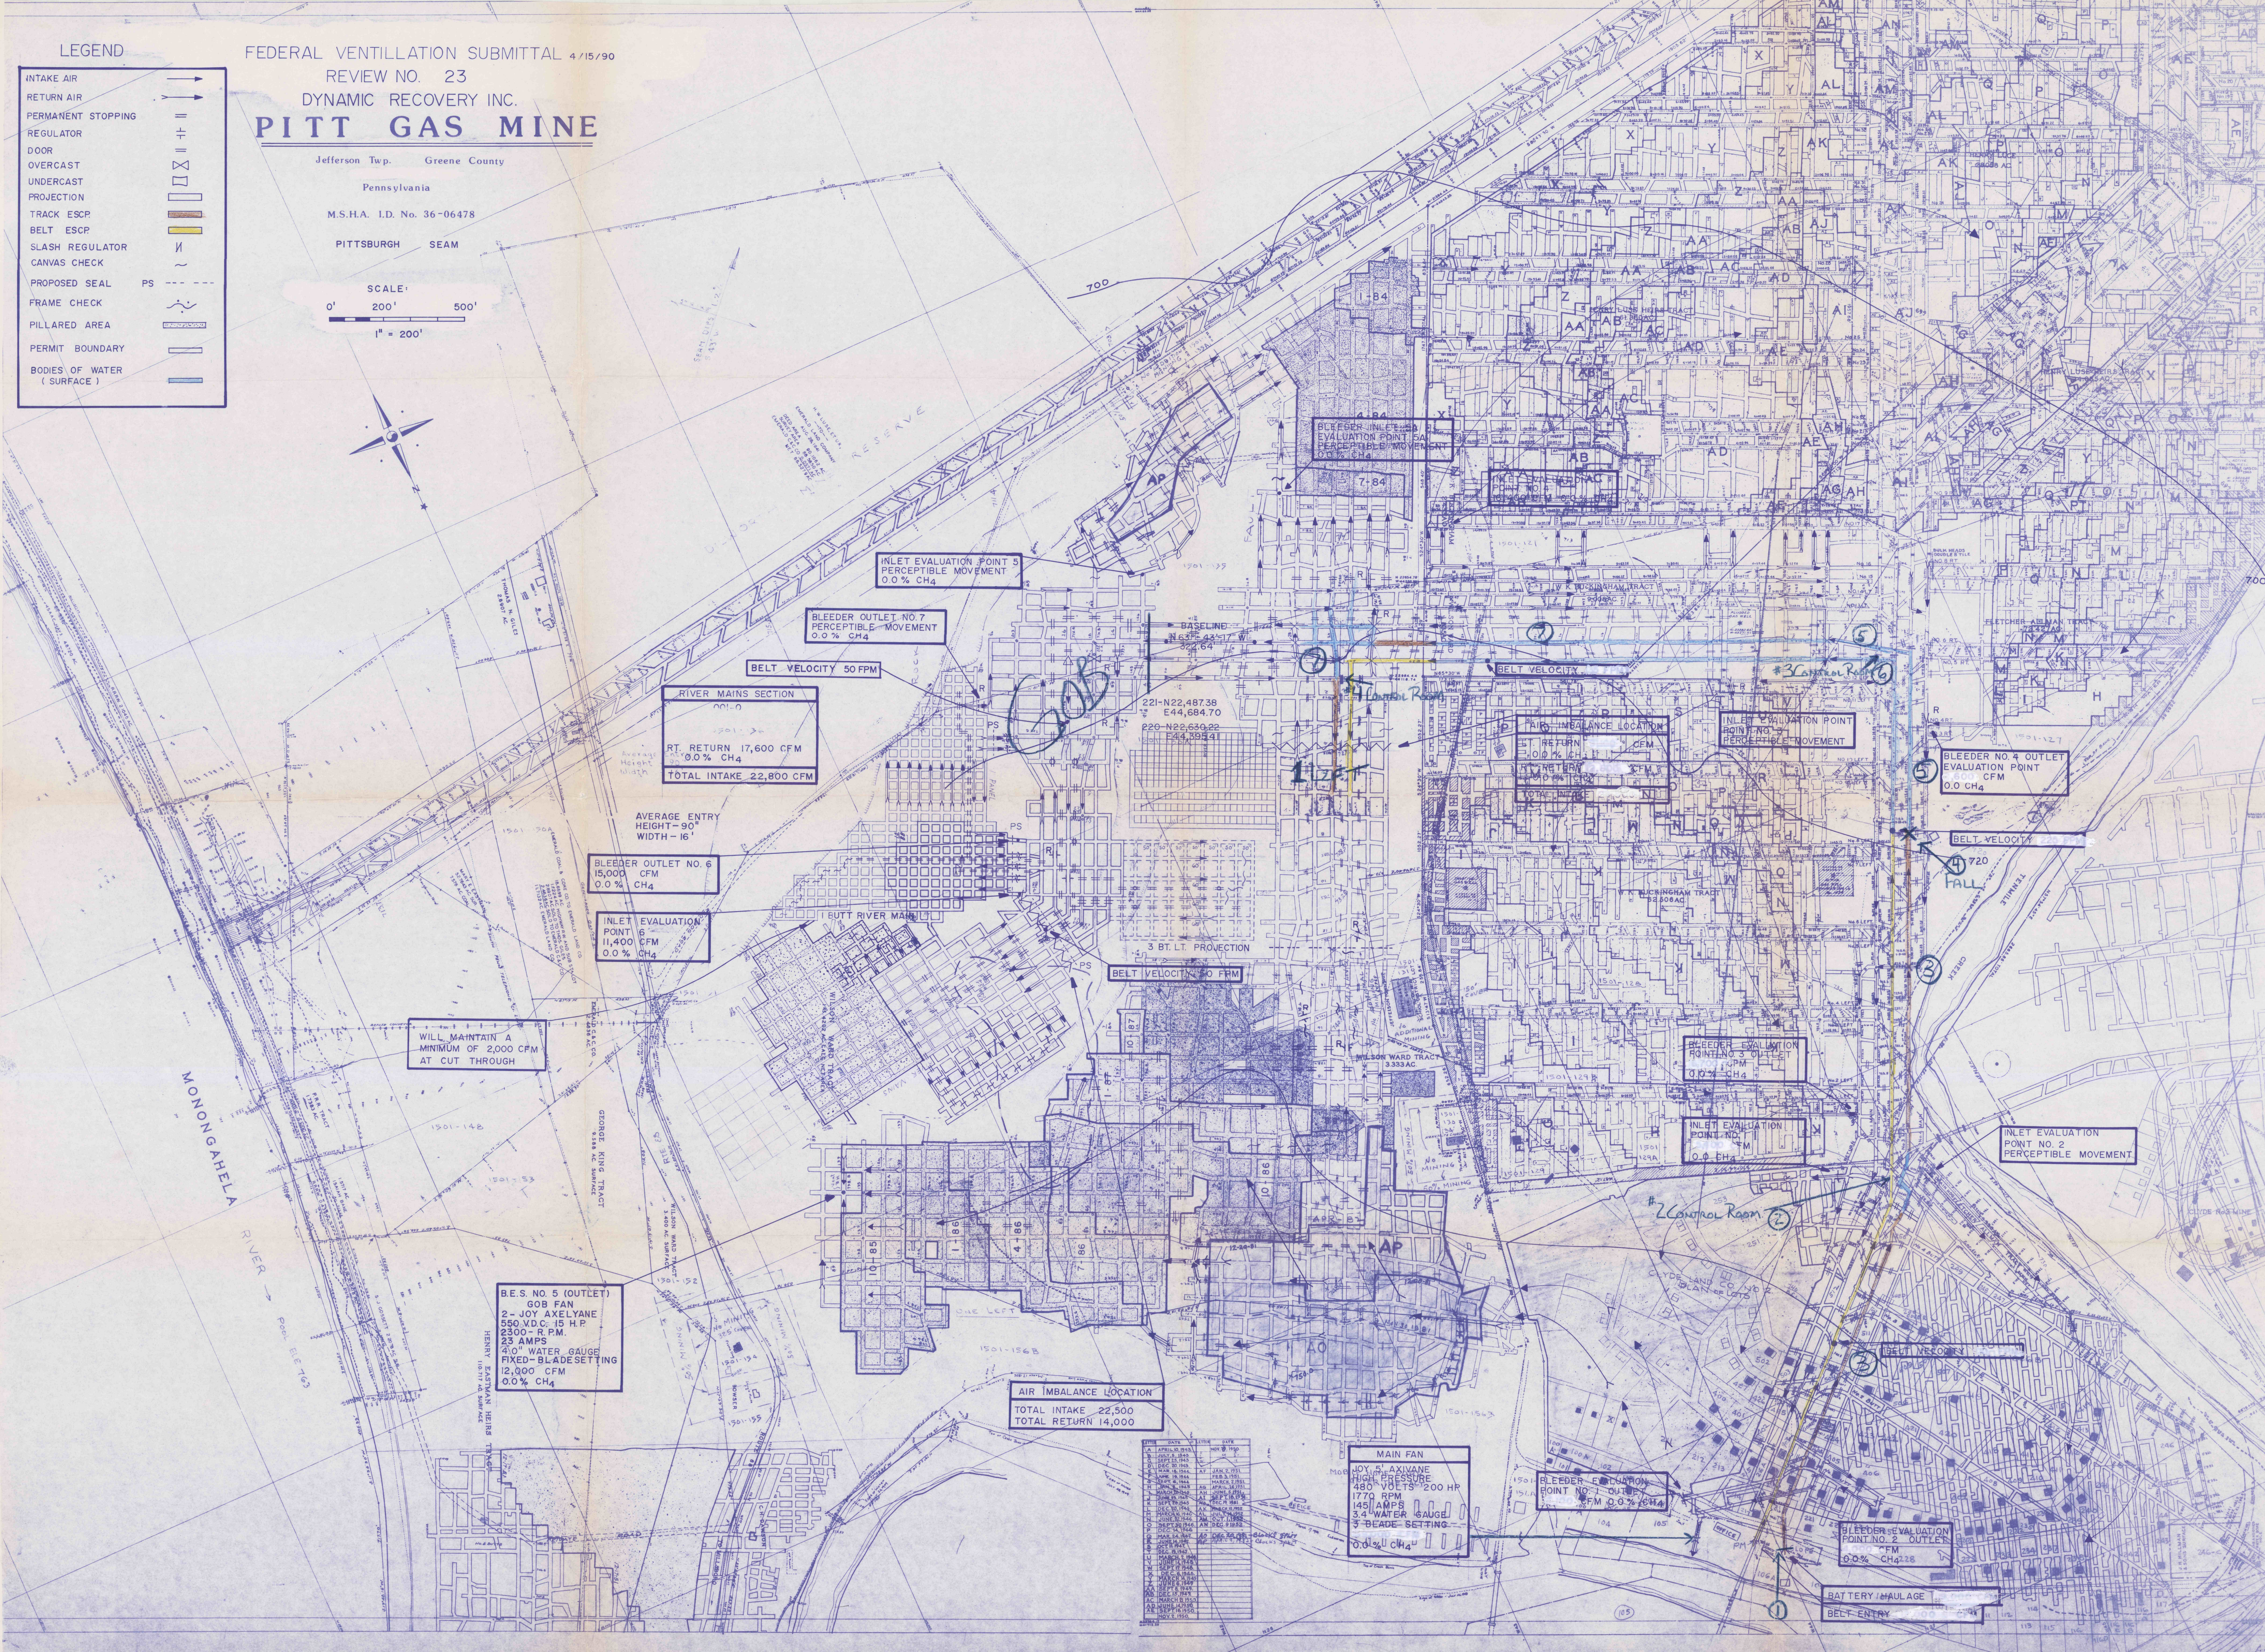

INLET EVALUATION POINT 5
PERCEPTIBLE MOVEMENT
0.0% CH₄

BLEEDER OUTLET NO 7
PERCEPTIBLE MOVEMENT
0.0% CH₄

BELT VELOCITY 50 FPM

RIVER MAINS SECTION
RT RETURN 17,600 CFM
0.0% CH₄
TOTAL INTAKE 22,800 CFM

AVERAGE ENTRY
HEIGHT - 90"
WIDTH - 16'
BLEEDER OUTLET NO 6
15,000 CFM
0.0% CH₄

INLET EVALUATION
POINT 6
11,400 CFM
0.0% CH₄

WILL MAINTAIN A
MINIMUM OF 2,000 CFM
AT CUT THROUGH

B.E.S. NO. 5 (OUTLET)
2 - JOY AXELVANE
550 V.D.C. 15 H.P.
2300 - R.P.M.
23 AMPS
41" WATER GAUGE
FIXED - BLADE SETTING
12,000 CFM
0.0% CH₄

AIR IMBALANCE LOCATION
TOTAL INTAKE 22,500
TOTAL RETURN 14,000

MAIN FAN
JOY AXELVANE
HIGH PRESSURE
480 VOLTS - 200 HP
1770 RPM
145 AMPS
3.4" WATER GAUGE
3 - BLADE SETTING
0.0% CH₄

BLEEDER EVALUATION
POINT NO. 1 OUTLET
12,000 CFM
0.0% CH₄

BLEEDER EVALUATION
POINT NO. 2 OUTLET
12,000 CFM
0.0% CH₄

BATTERY HAULAGE
BELT ENTRY


4/16/90
S/S/90