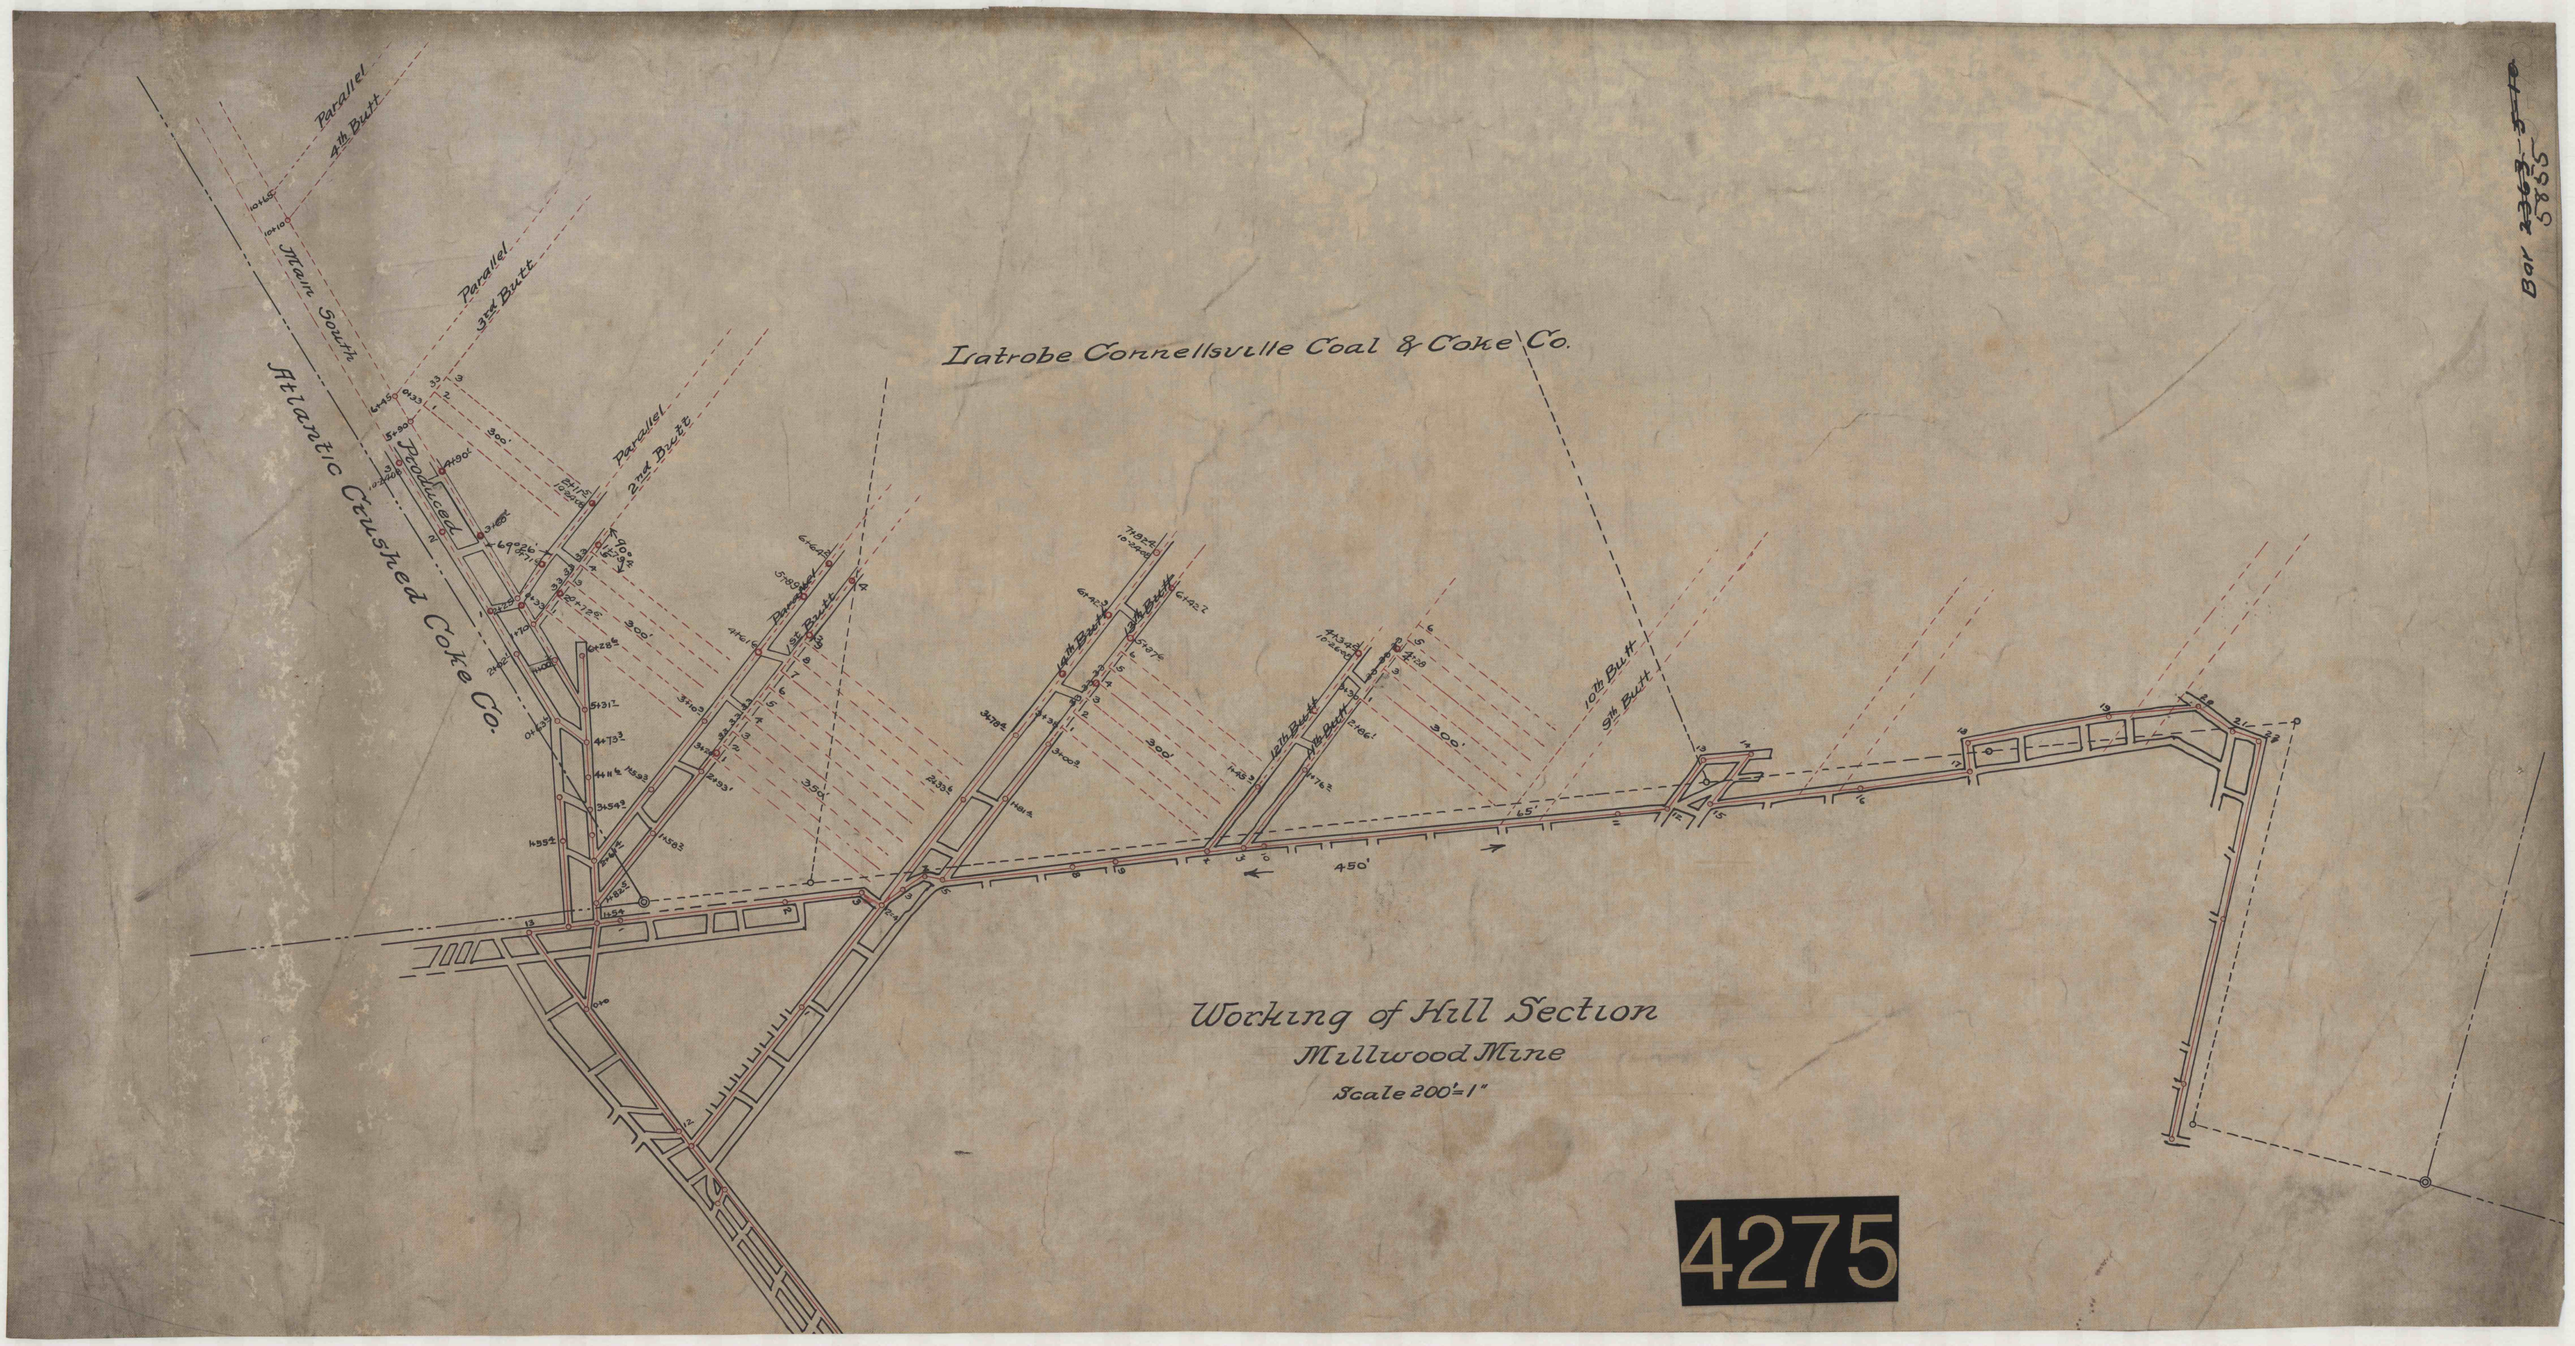
Parallel 4th Butt
Main South
Parallel 3rd Butt
Parallel 2nd Butt
Atlantic Crushed Coke Co.
Produced
Latrobe Connellsville Coal & Coke Co.
14th Butt
13th Butt
12th Butt
11th Butt
10th Butt
9th Butt
300'
350'
450'
65'
Working of Hill Section
Millwood Mine
Scale 200'=1"
4275
Bar 2363-Folio 5885