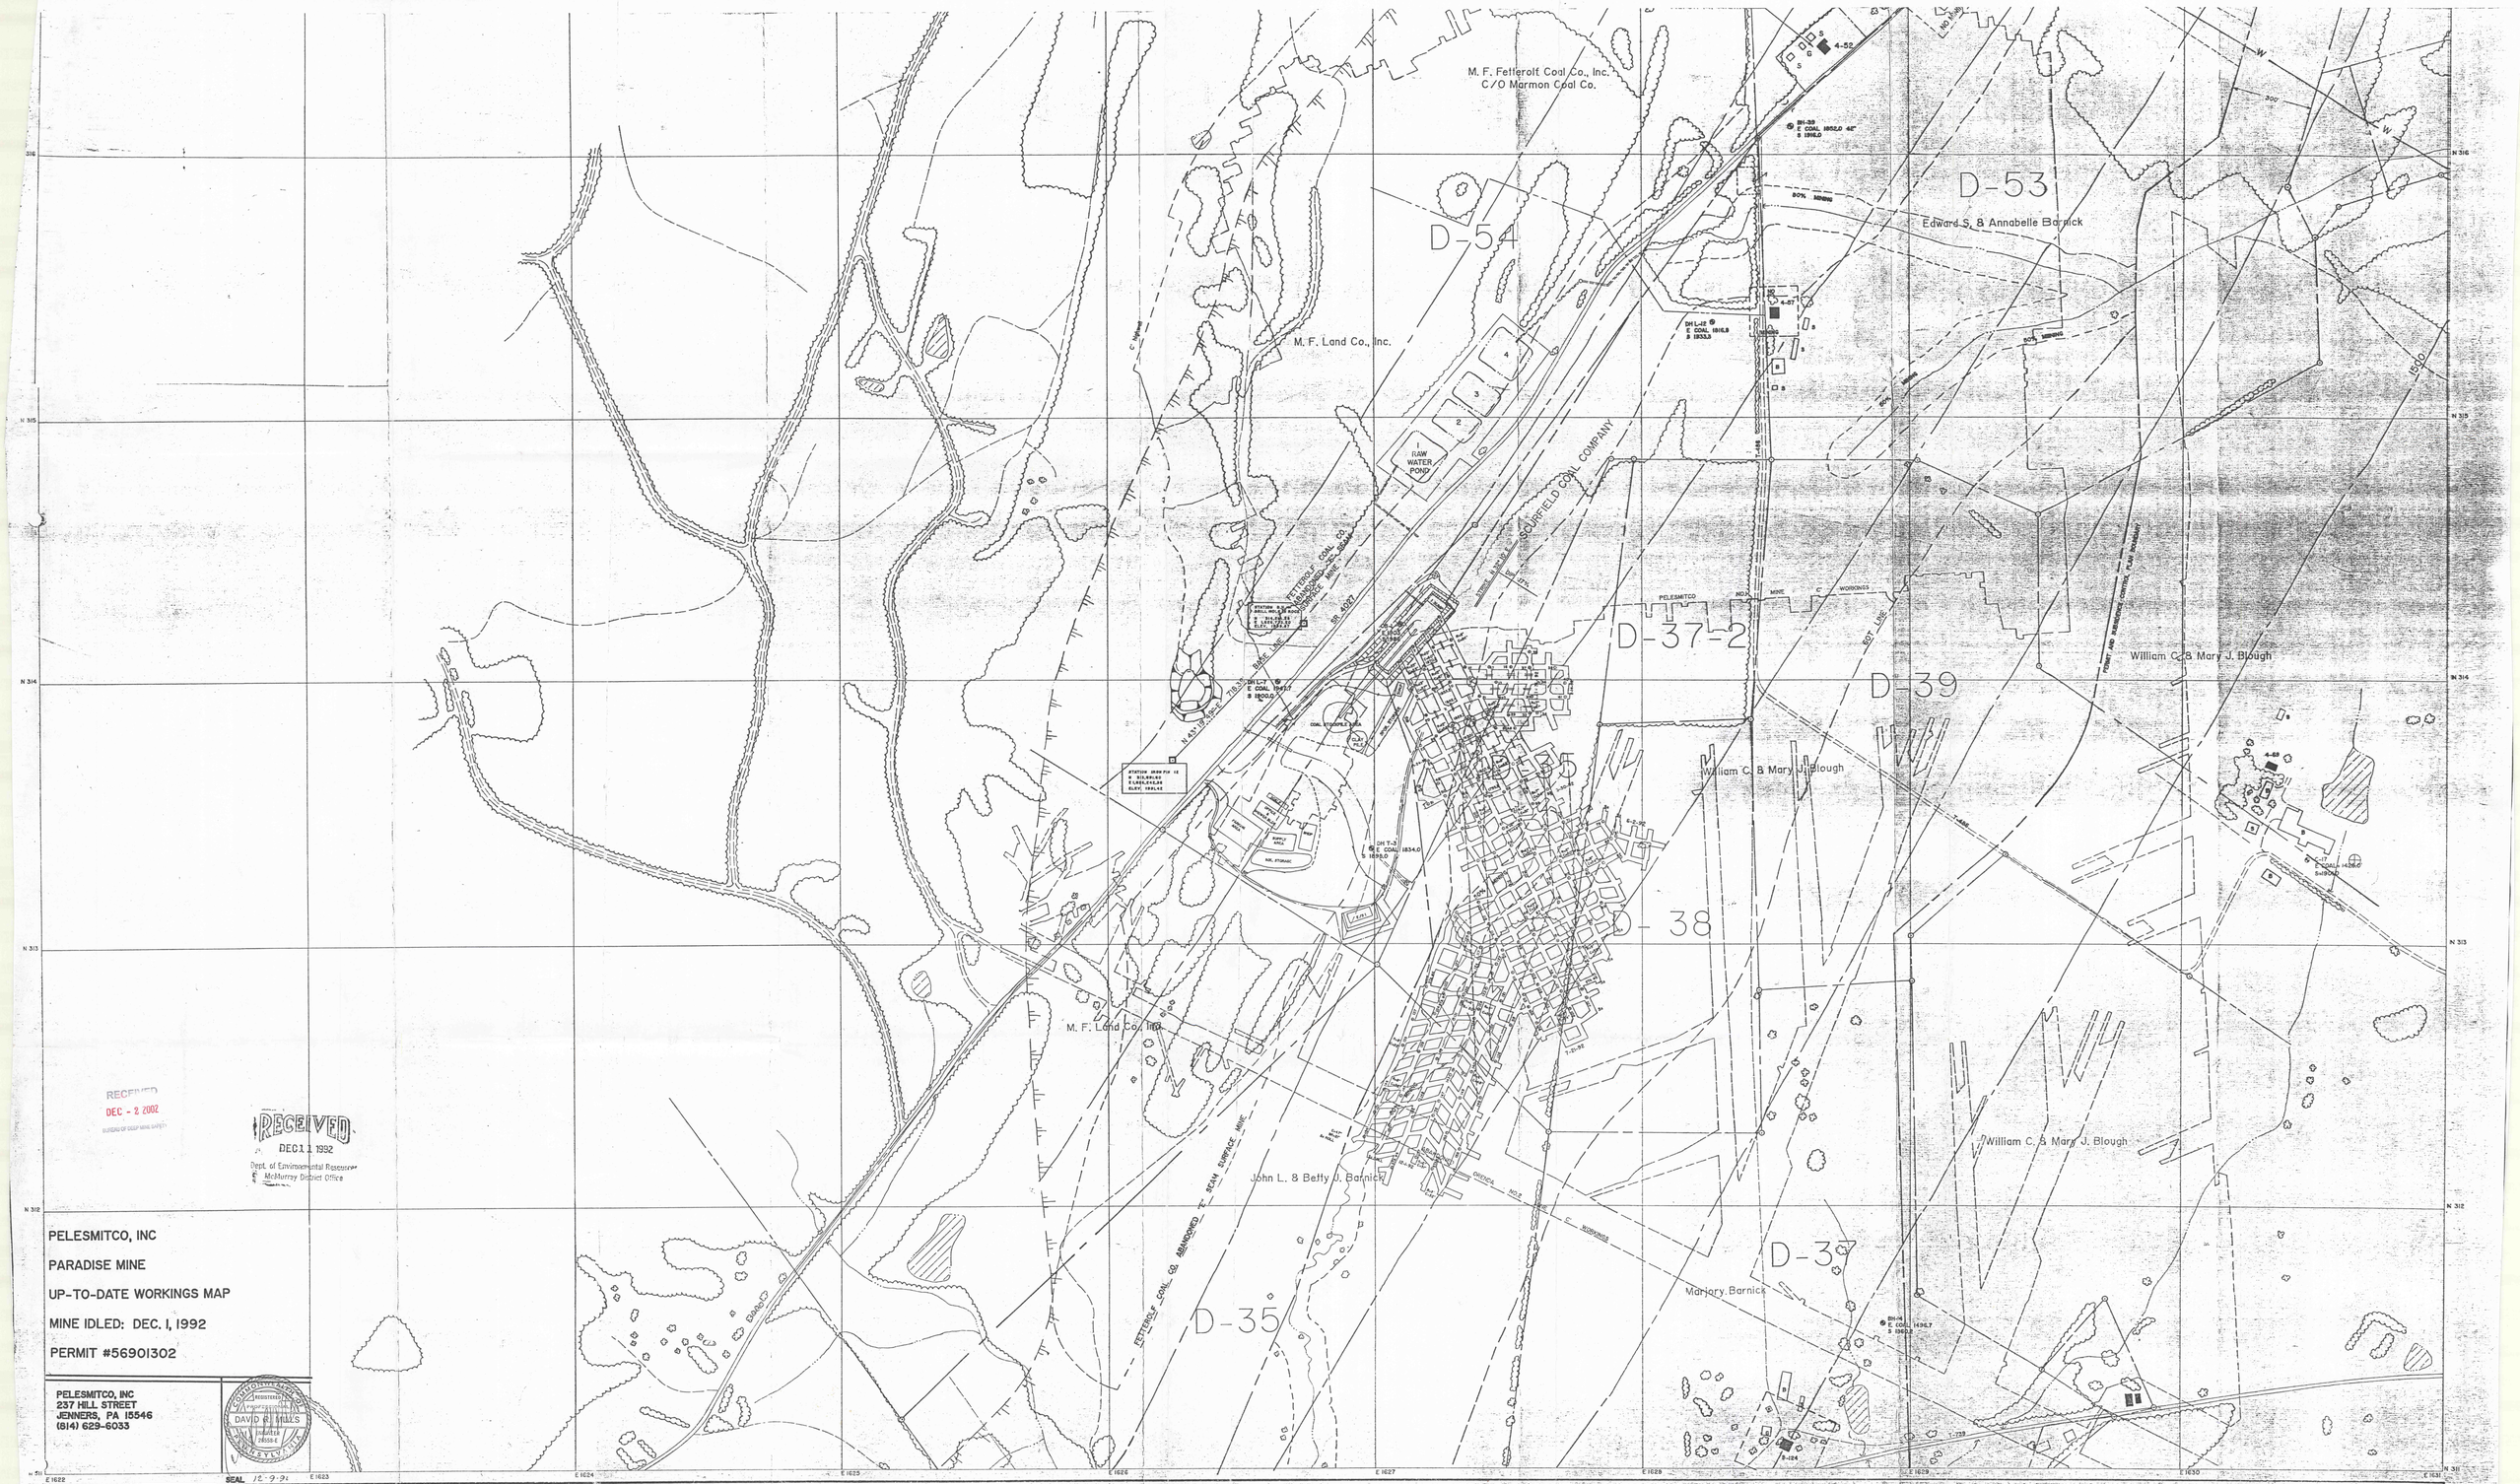


RECEIVED
DEC - 2 2002
BUREAU OF DEEP MINE SAFETY

RECEIVED
DEC 11 1992
Dept. of Environmental Resources
McMurray District Office

PELESMITCO, INC

PARADISE MINE

UP-TO-DATE WORKINGS MAP

MINE IDLED: DEC. 1, 1992

PERMIT #56901302

PELESMITCO, INC
237 HILL STREET
JENNERS, PA 15546
(814) 629-6033

COMMONWEALTH OF PENNSYLVANIA
REGISTERED PROFESSIONAL
DAVID R. MILLS
PROFESSIONAL ENGINEER
28558-E

SEAL 12-9-92

P4
4286

JENNER TOWNSHIP & JENNERSTOWN BORO
SOMERSET COUNTY
PENNSYLVANIA

John Doe SURFACE OWNERSHIP
JOHN DOE SUBSURFACE OWNERSHIP
NOTE: D-#'S REPRESENT SUBSURFACE OWNERSHIP BY M.F. LAND CO., INC.

LEGEND
UNPAVED ROAD
PAVED ROAD
U.S. ROUTE
INTERSTATE
LEGISLATIVE ROUTE
TOWNSHIP ROUTE
RAILROAD
LAKE, POND
FENCE
SWAMP
WOODS LINE
BENCH MARK
TRAVERSE STATION
PHOTOGRAMMETRIC POT ELEVATION
CONTOURS
PHOTO CENTER
UPPER FREEPORT COAL CONTOURS
UPPER KITTANNING ICE MINE WORKINGS

SCALE: 1" = 200'
200' 0 200' 400' 600' 800'

NORTH

SHEET INDEX

PLANIMETRIC SERIES

SHEET NO. A-2