


Sarah Resources, Inc.
 Sarah Mine
Final Mine Map
Temporarily Sealed
 MSHA I.D. No. 36-08571
 CMAP # 56961301
 Date: 09-05-03
 Scale: 1" = 200'
 Jenners Twp. & Jennerstown Boro
 Somerset County, Pennsylvania
 P.O. Box 240
 Friedens, PA 15541
 Phone: 814-629-1379
 Fax: 814-629-8870

Ventilation Legend

- Intake Air
- Return Air
- Belt Air
- Primary Escapeway
- Secondary Escapeway
- Stopping with Door
- Stopping with opening equal to a block or blocks
- Overcast
- Regulator
- Impounded Water
- Contour Line
- Canvas Check
- Projected Seals
- 12" Metal Vent Pipe
- Covered Areas
- Safety Zone, 50% Mining
- Airlock
- Drillholes
- Permit Line
- Streams
- Surface Property Lines
- Dwellings
- Shed
- Garage
- Roads
- Public Waterlines
- Adjacent Workings Labeled
- Main Fan
- Spud

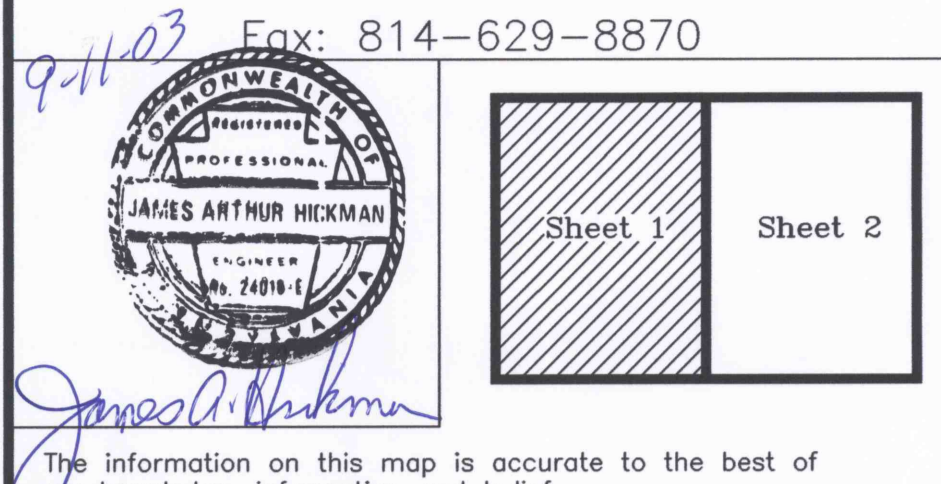

The information on this map is accurate to the best of my knowledge, information and belief.

A closed loop check survey (closure 1 in 293,721) was completed from control points on the surface to spot number 23 in accordance with the Pennsylvania Surveying and Mapping Act. All surveys on this point are open ended traverses.

The mine workings are plotted from mine surveys conducted by the technical engineering department after February 15, 2000 (all areas rely the month of Postmine Month).

All other areas of the mine were surveyed while the mine was operated by Penn Coal, Inc. (Closed loop check survey, and East Mine by Penn Coal, Inc. Since this surveying and mapping was done by the previous owner, the accuracy of the surveying and mapping cannot be warranted by the engineer certifying this final map.

The certification of this final map is based on prior certification. Original mapping was provided by Penn Coal, Inc.

HBGHT- 84'
 MDTM- 20'

Notes:
 Closed loop surveys meet the 1/25,000 accuracy requirements.
 There are no known oil or gas wells located within the permit area.
 All boundaries are graded to the best of my knowledge.

- Notes:**
- All faults, wants, or areas where the coal seam thins to unminable thickness are labeled as such on the map.
 - There are no areas designated unsuitable for mining at the present time.
 - There are no waste disposal sites or coal refuse disposal sites within 1000' of the Permit and Subsidence Control Plan Boundary.
 - There are no coal seams below the Upper Kittanning which outcrop within 1000' of the permit area.
 - There are no cemeteries, public parks, historic structures, gas or oil wells, or major electric transmission lines within our subsidence control plan boundary.
 - The coordinate system is based upon USGS, Pennsylvania State Plane, 1927, PA South. Topography by photogrammetric methods from aerial photographs taken in 1991.
 - The portal elevations for the Sarah Mine are as follows:
 #1 Ent. = 1897', #2 Ent. = 1902', #3 Ent. = 1907'

- Legend**
- Area of Potential Influence
 - Paved Roadway
 - Unimproved dirt road
 - Surface Permit Area
 - Upper Kittanning coal outcrop
 - Upper Freeport coal outcrop
 - Underground Permit/Subsidence Control Plan Boundary
 - 30° Angle of Draw Line From Permit Line
 - Mineral owned by Walter & Viola Willison, (All other mineral in the permit area is owned by M.F. Land, Co.)
 - 1000' Adjacent Limit Line to Permit Line
 - Dwellings, H1, H2, etc. denotes more than one dwelling on a surface tract of land.
 - Jennerstown Water Line
 - Jennerstown Sewer Line
 - Structures: S-Shed, G-Garage, B-Barn, P denotes a public building
 - RoxCoal, Sarah Mine Perimeter
 - RoxCoal, Sarah Mine Openings, #1, #2, & #3

Identification of Existing (S)urface and (D)eep Mines

- (A) Consolidated Coal Company Mine #119 - C', Abandoned (D)
- (B) Consolidated Coal Company Mine #123 - E, Abandoned (D)
- (C) J. Stuft Mine - E, Abandoned (D)
- (D) John Cable - E, Abandoned (D&S)
- (E) Fetterolf Coal Company - E, Abandoned (S)
- (F) Davis Coal & Coke, Brenda #2 Mine - C', Abandoned (D)
- (G) Laura D. Coal, Inc. (SMP#5688104) - C' & E, Inactive (S)
- (H) Pelesnitco, Inc. (CMAP#56901302) - E, Inactive (D)

