




FINAL MAP Last Mining: 3-15-99
FEB 01 2001
RECEIVED FEB 05 2001
Dept. of Environmental Protection
McMurry District Office

MINE I.D. 36-06289

| LEGEND | |
|--------|------------------------------------|
| | Individual Responsible JEFF ROSE |
| | POWER HOLE PRESIDENT |
| | OVERCAST UNDERCAST |
| | DOOR |
| | CONTINGENT MINING |
| | TEMPORARY STOPPING |
| | STOPPING CEMENT |
| | PROPOSED SEALS P AND WHEN REQUIRED |
| | INTAKE EVALUATION POINT |
| | PIPE OVERCAST |
| | REGULATOR |
| | URGENT WATER |
| | RESTRICTED AIR FLOW |

This map satisfies both 75:1200 & 75:372
NOTE: There is no mining above or below the Solar No. 10 Permit Area.

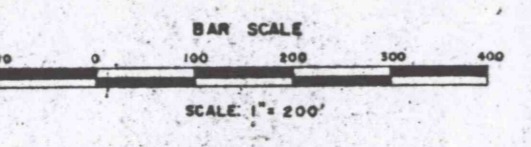

CONTRACT OPERATOR
Pierpont Mining, Inc.
P.O. Box 286
Somerset, PENNA. 15501

SHEET INDEX

| | | | | | | | |
|----|----|----|----|----|----|----|----|

19.5 Six Month Projection Map

| | |
|--|-------------|
| SOLAR No 10 MINE QUEMANNING TWP. SOMERSET CO. UPPER KITTANNING - C' SEAM. | DATE: |
| SOLAR FUEL COMPANY BOX 488 SOMERSET, PENNA. 15501 | DWG. NO. 14 |
| REVISIONS: | |