


THIS PLANIMETRIC MAP PREPARED BY L. ROBERT KIMBALL & ASSOCIATES' Consulting Engineers & Architects EPHRATA, PENNSYLVANIA, BY PHOTOGRAMMETRIC METHODS FROM AERIAL PHOTOGRAPHY DATED DECEMBER 4, 1979

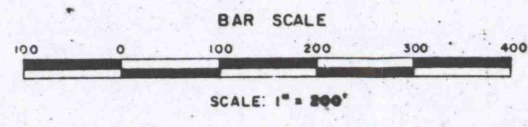

SHEET INDEX

07	08	09	10	11	12	13	14	15	16
17	18	19	20	21	22	23	24	25	26
27	28	29	30	31	32	33	34	35	36
37	38	39	40	41	42	43	44	45	46
47	48	49	50	51	52	53	54	55	56
57	58	59	60	61	62	63	64	65	66
67	68	69	70	71	72	73	74	75	76
77	78	79	80	81	82	83	84	85	86
87	88	89	90	91	92	93	94	95	96
97	98	99	00	01	02	03	04	05	06

FEB 05 2001
 Dept. of Environmental Protection
 McMurray District Office

FINAL MAP Last Mining: 3-15-99
19.5 Six Month Projection Map

SOLAR NO 10 MINE
 QUEMAMONING TWP SOMERSET CO.
 UPPER KITTANNING - C SEAM

SOLAR FUEL COMPANY
 BOX 488
 SOMERSET, PENNA. 15501

DATE: _____
 DWG. NO: 19

REVISIONS: _____

SOLAR-10-N09 N9