

**LEGEND**

MINE ACTIVITY PERMIT NO.56841318

BOUNDARY OF SUBSIDENCE PERMIT: [Symbol]

PROTECTED STRUCTURES: [Symbol] 2

OTHER STRUCTURES: [Symbol] 2A,2B

DENOTES BUILT AFTER THE ACT: [Symbol] AA

OCCUPANT - NOT OWNER: [Symbol] 3L

CONTEMPLATED MINING: [Symbol] TO [Symbol]


SUPPORT AREA: [Symbol]

PAST SIX MONTH MINING: [Symbol]

WELL: [Symbol]

SPRING: [Symbol]

C PRIME - UPPER KITTANNING


  
**RECEIVED**  
 FEB 05 2001  
 Dept. of Environmental Protection  
 McMurray District Office


FEB 04 2001  
**FINAL MAP** Last Mining: 3-15-99  
 (9.5 Six Month Projection Map)

**PIERPONT NO.10 MINE**  
 QUEMAHONING TOWNSHIP SOMERSET COUNTY  
 UPPER KITTANNING - C' SEAM  
  
 CONTRACT OPERATOR  
**PIERPONT MINING, INC.**  
 P.O. BOX 286  
 SOMERSET, PA. 15501

**SOLAR NO.10 MINE**  
 QUEMAHONING TOWNSHIP SOMERSET COUNTY  
 UPPER KITTANNING - C' SEAM  
  
**SOLAR FUEL COMPANY**  
 BOX 488  
 SOMERSET, PA. 15501

SHEET INDEX

M11	M12	N9
M15	M16	N13
M19	M20	N17

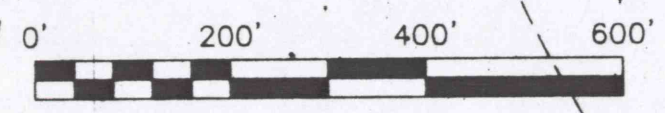

S:\Mining\PIERPONT MINING INC\NUM 10 MINE\DRAWINGS\0110.dwg Copyright 2000, Musser Engineering, Inc.