

D. SEAM MINING

A. McCOMBIE

JAS. SHEERY

REILLY COAL CO
D. SEAM MINING



D. GRAY

SPANGLER

I. KNEFF

A. FARRELL

1" = 200'
FILE D-429

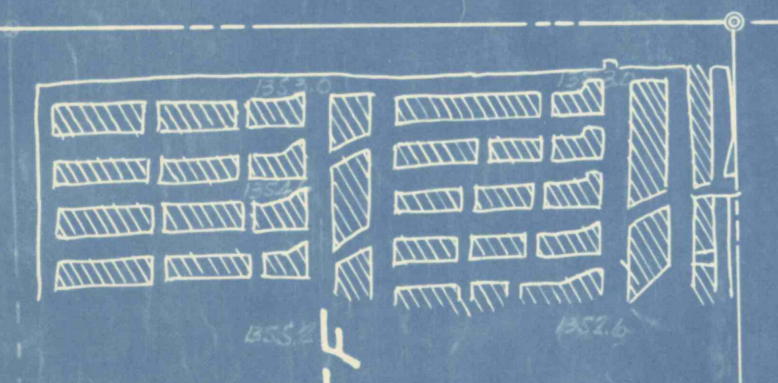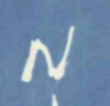

STEVE MAMMO JOHN SHARL NIVE SHERRY
FRANK McCOMBIE

JOHN KNATH

FRANK McCOMBIE

WEST BRANCH

FRANK McCOMBIE

FRANK McCOMBIE

REILLY COAL CO

D. GRAY

SPANGLER

MADDERHILL B. LINE

RIVER

BROOKLINE










