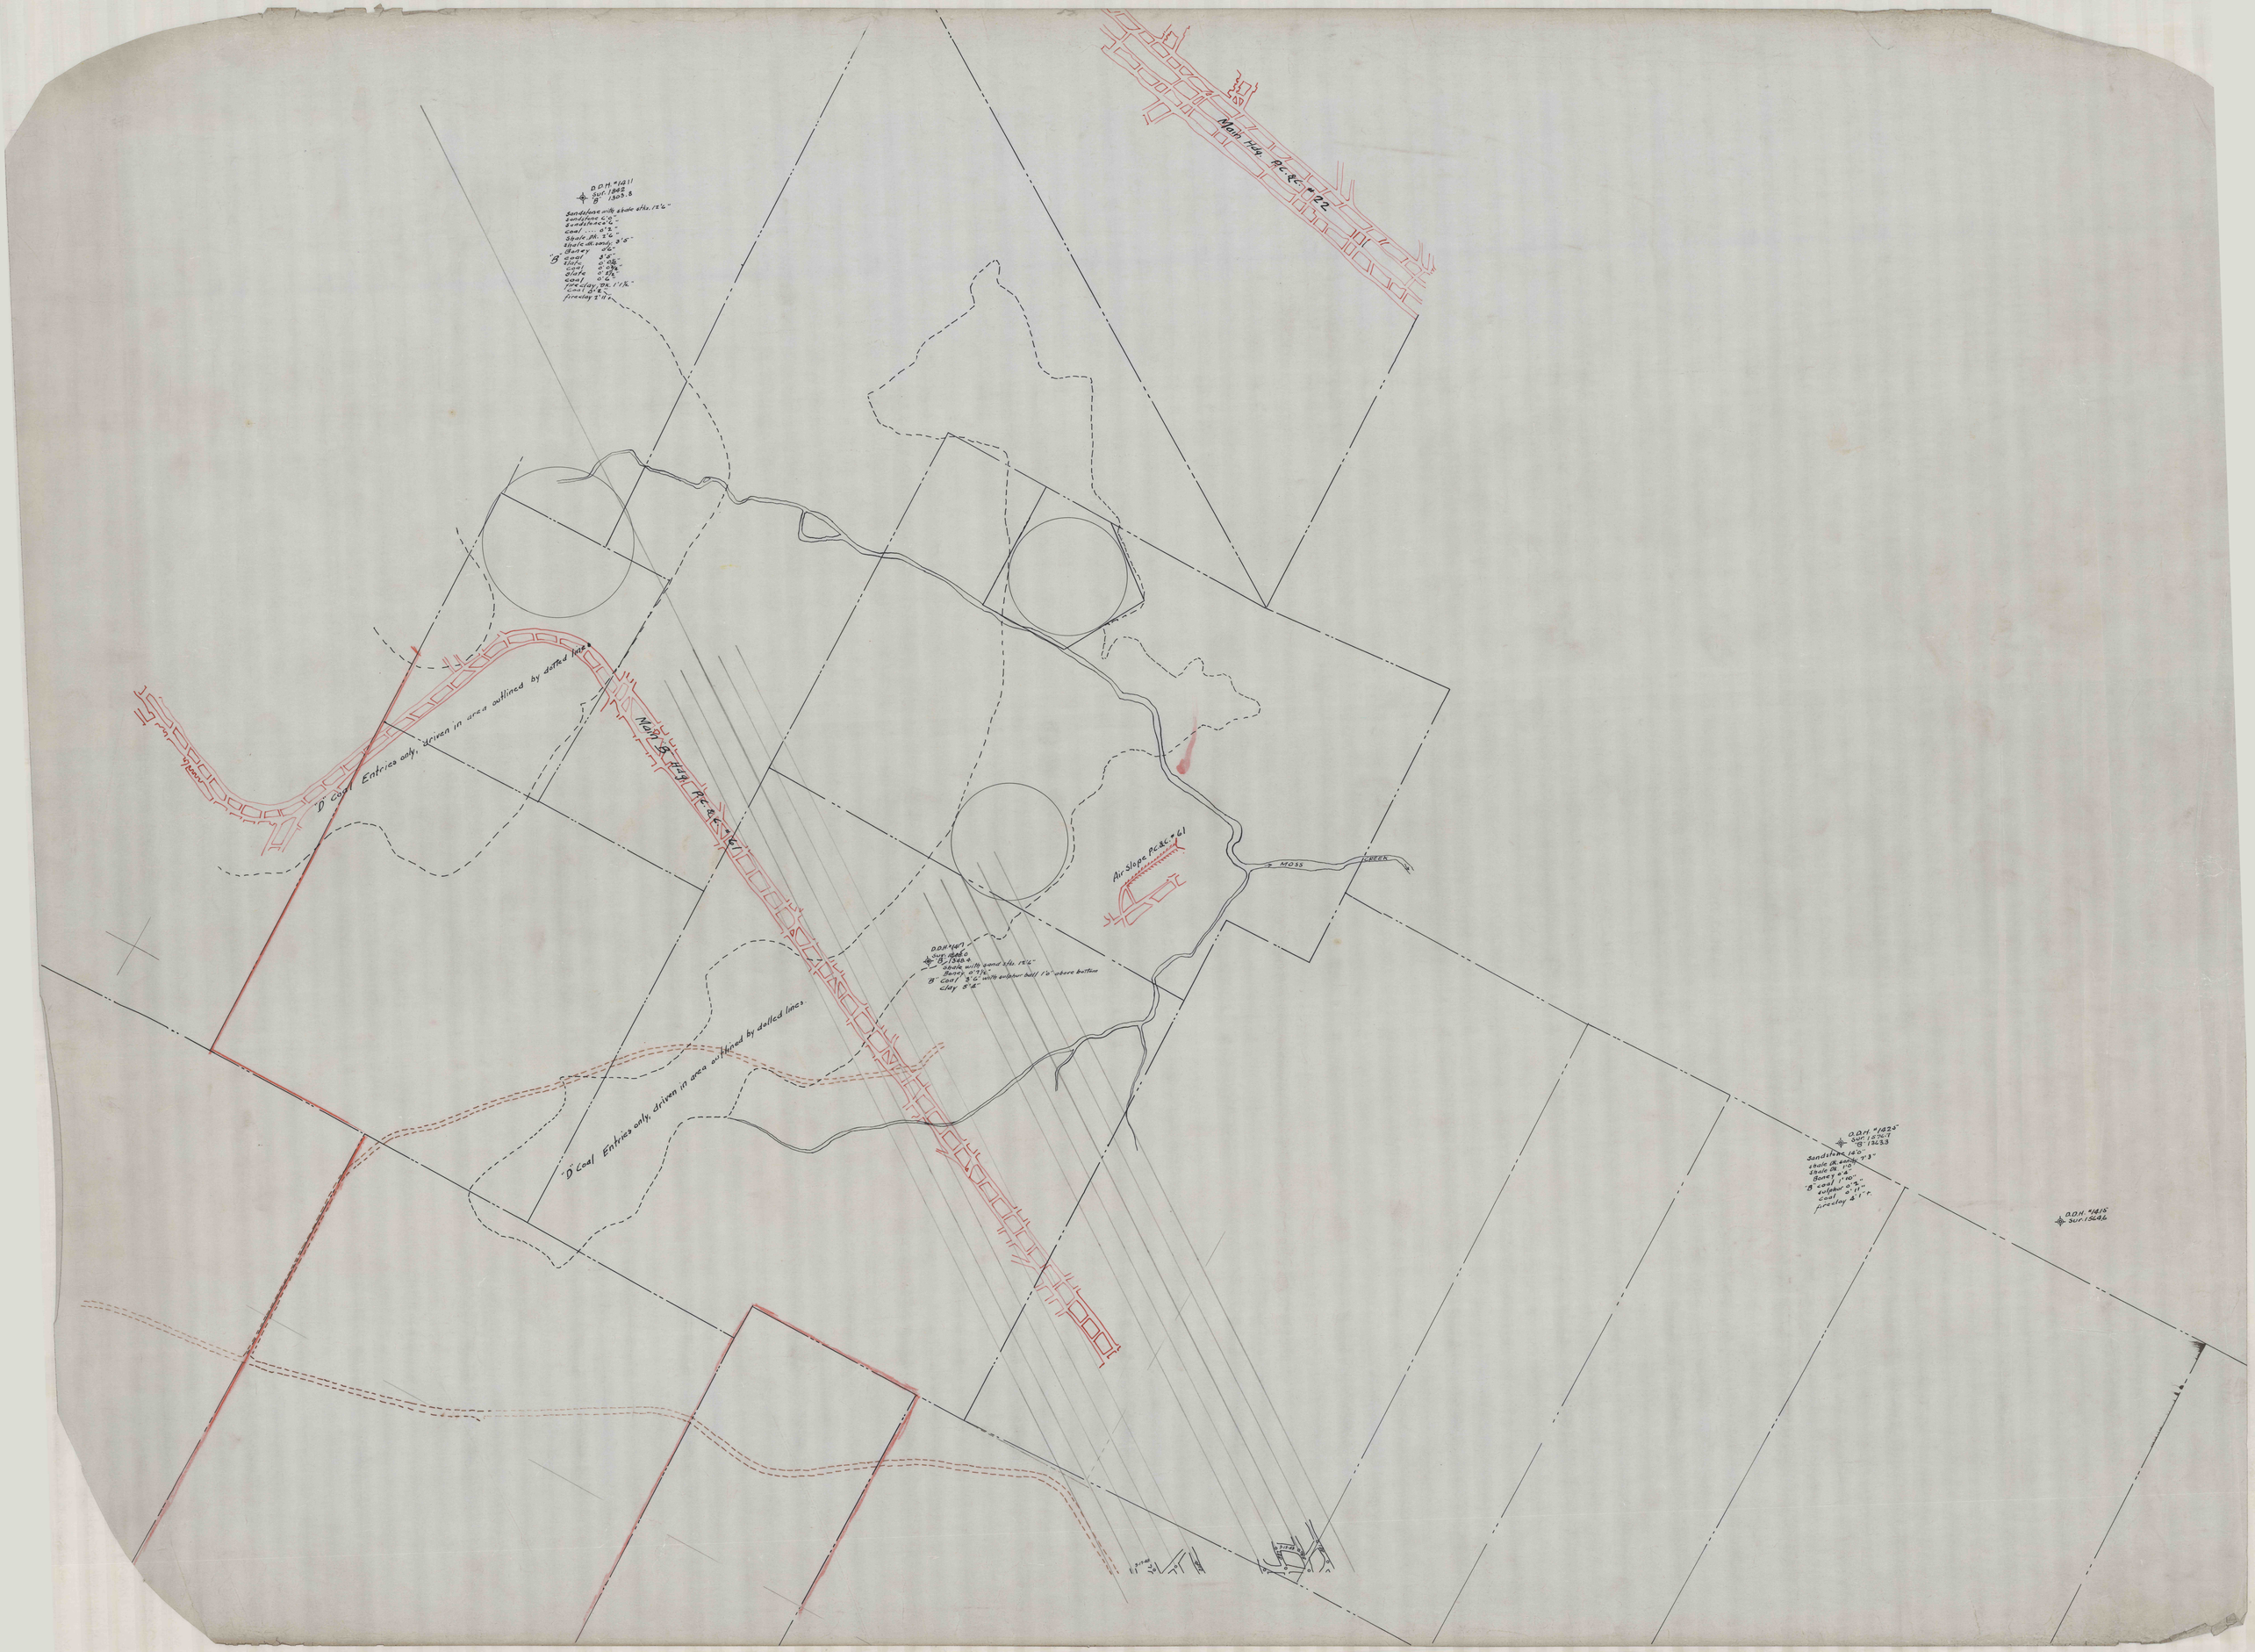

D.D.H. #1411
Sur. 1842
B 1303.8
Sandstone with shale stks. 12'6"
Sandstone 6'0"
Sandstone 0'6"
Coal ... 0'2"
Shale Bk. 2'6"
Shale dk. sandy 3'5"
Boney 0'6"
"B" Coal 3'5"
Slate 0'0½"
Coal 0'0½"
Slate 0'2½"
Coal 0'6"
Fireclay Bk. 1'1½"
Coal 0'2"
Fireclay 2'11"
Main Hdg. P.C.&C. #22
"D" Coal Entries only, driven in area outlined by dotted lines.
Main B Hdg. P.C.&C. #61
Air Slope P.C.&C. #61
MOSS CREEK
D.D.H. #1417
Sur. 1848.0
"B" 1348.4
Shale with sand stks. 12'6"
Boney 0'7½"
"B" Coal 3'6" with sulphur ball 1'0" above bottom
Clay 5'4"
"D" Coal Entries only, driven in area outlined by dotted lines.
D.D.H. #1425
Sur. 1576.7
"B" 1363.3
Sandstone 14'0"
Shale Bk. sandy 7'3"
Shale Bk. 1'0"
Boney 0'4"
"B" Coal 1'10"
Sulphur 0'2"
Coal 0'11"
Fireclay 4'1" +
D.D.H. #1415
Sur. 1564.6