


MAP OF
REILLY NO 1 MINE
 'B' SEAM
 OPERATED BY
JOS. H. REILLY COAL CO.
SPANGLER GAMBRIA CO.
PENNA

Scale 1 inch = 200 FT Feb 1920
 Chas. E. Schlicher Engr
 Engineering Department, C.B.C. Corp.
 Traced From Blue Print. W. Good.

REVISED DATE OF LAST SURVEY
 MARCH 13 1934 P.S. DECEMBER 1933
 NOV. 14, 1934 M.M.C. 1 33 17 38
 SAME AS DATE ABANDONED (MAR. 28, 1935)

H.F. BIGLER ET. AL.

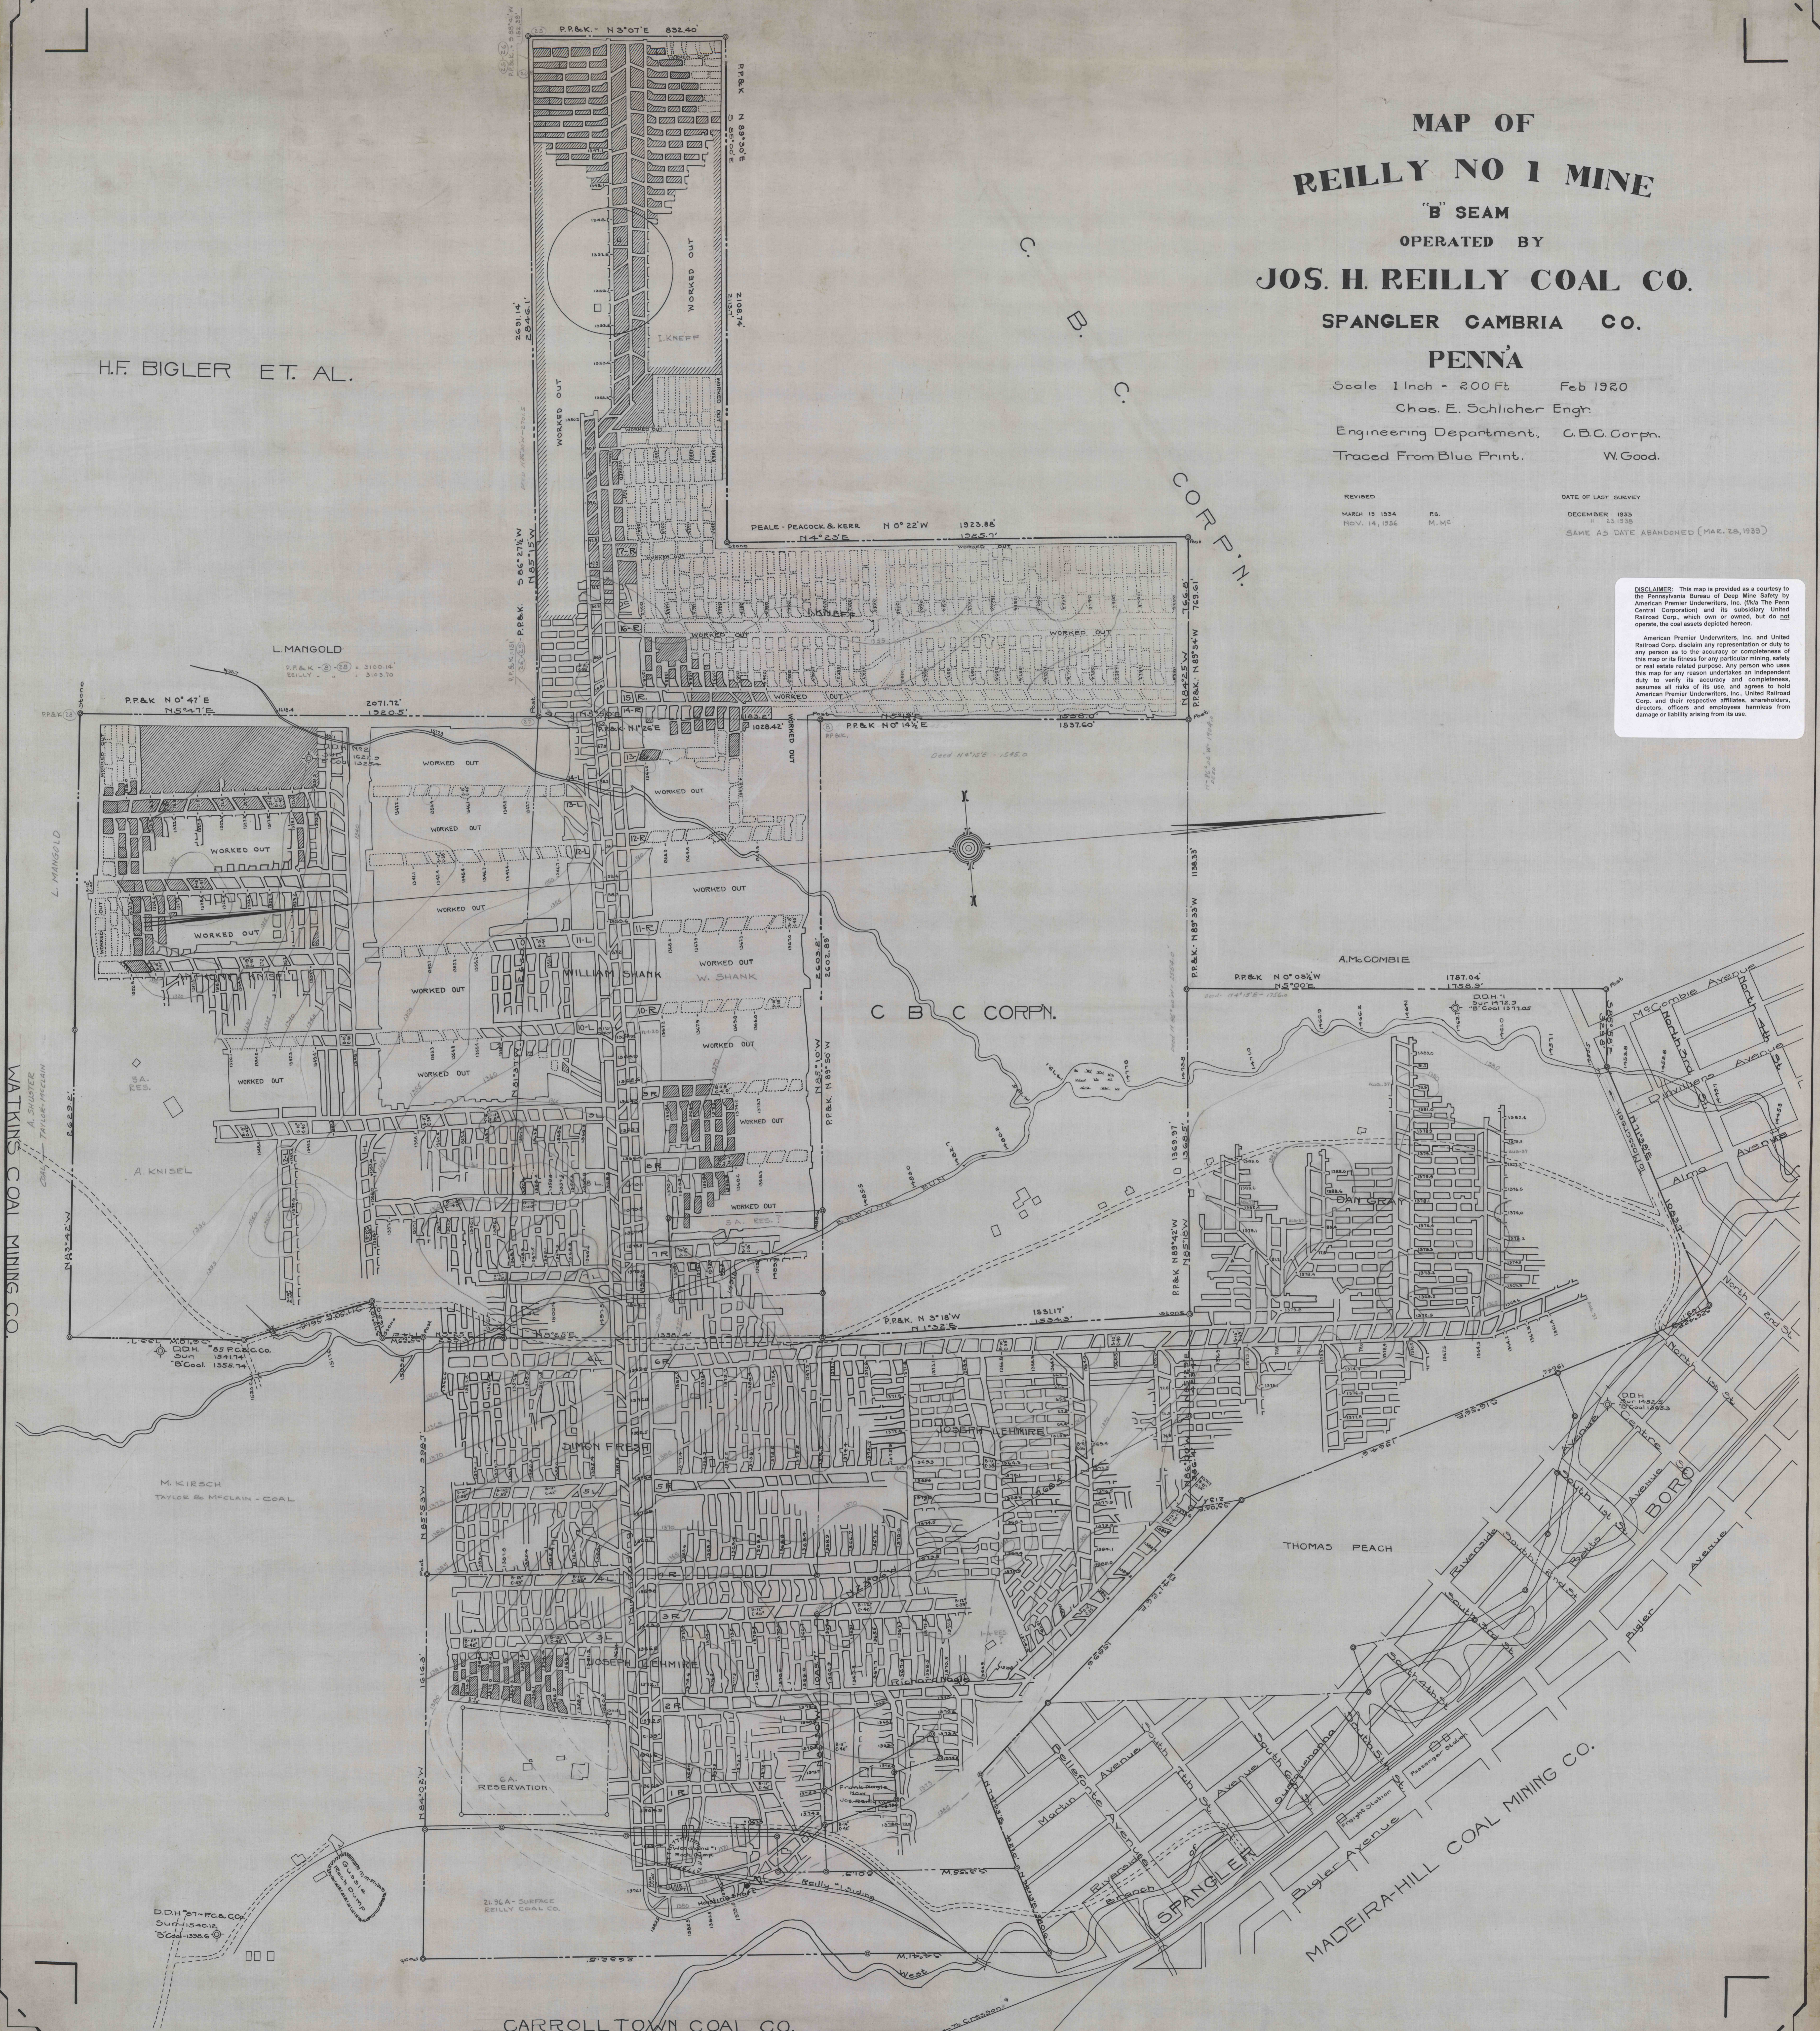

DISCLAIMER: This map is provided as a courtesy to the Pennsylvania Bureau of Deep Mine Safety by American Premier Underwriters, Inc. (The Penn Central Corporation) and its subsidiary United Railroad Corp., which own or owned, but do not operate, the coal assets depicted herein.

American Premier Underwriters, Inc. and United Railroad Corp. disclaim any representation or duty to any person as to the accuracy or completeness of this map or its fitness for any particular mining, safety or real estate related purpose. Any person who uses this map for any reason undertakes an independent duty to verify its accuracy and completeness, assumes all risks of its use, and agrees to hold American Premier Underwriters, Inc., United Railroad Corp. and their respective affiliates, shareholders, directors, officers and employees harmless from damage or liability arising from its use.

WATKINS COAL MINING CO.

MADEIRA HILL COAL MINING CO.

CARROLL TOWN COAL CO.