


MAP OF  
VICTOR NO. 10 MINE  
CARROLL TOWN COAL CO.  
ST. BENEDICT COUNTY, PA.

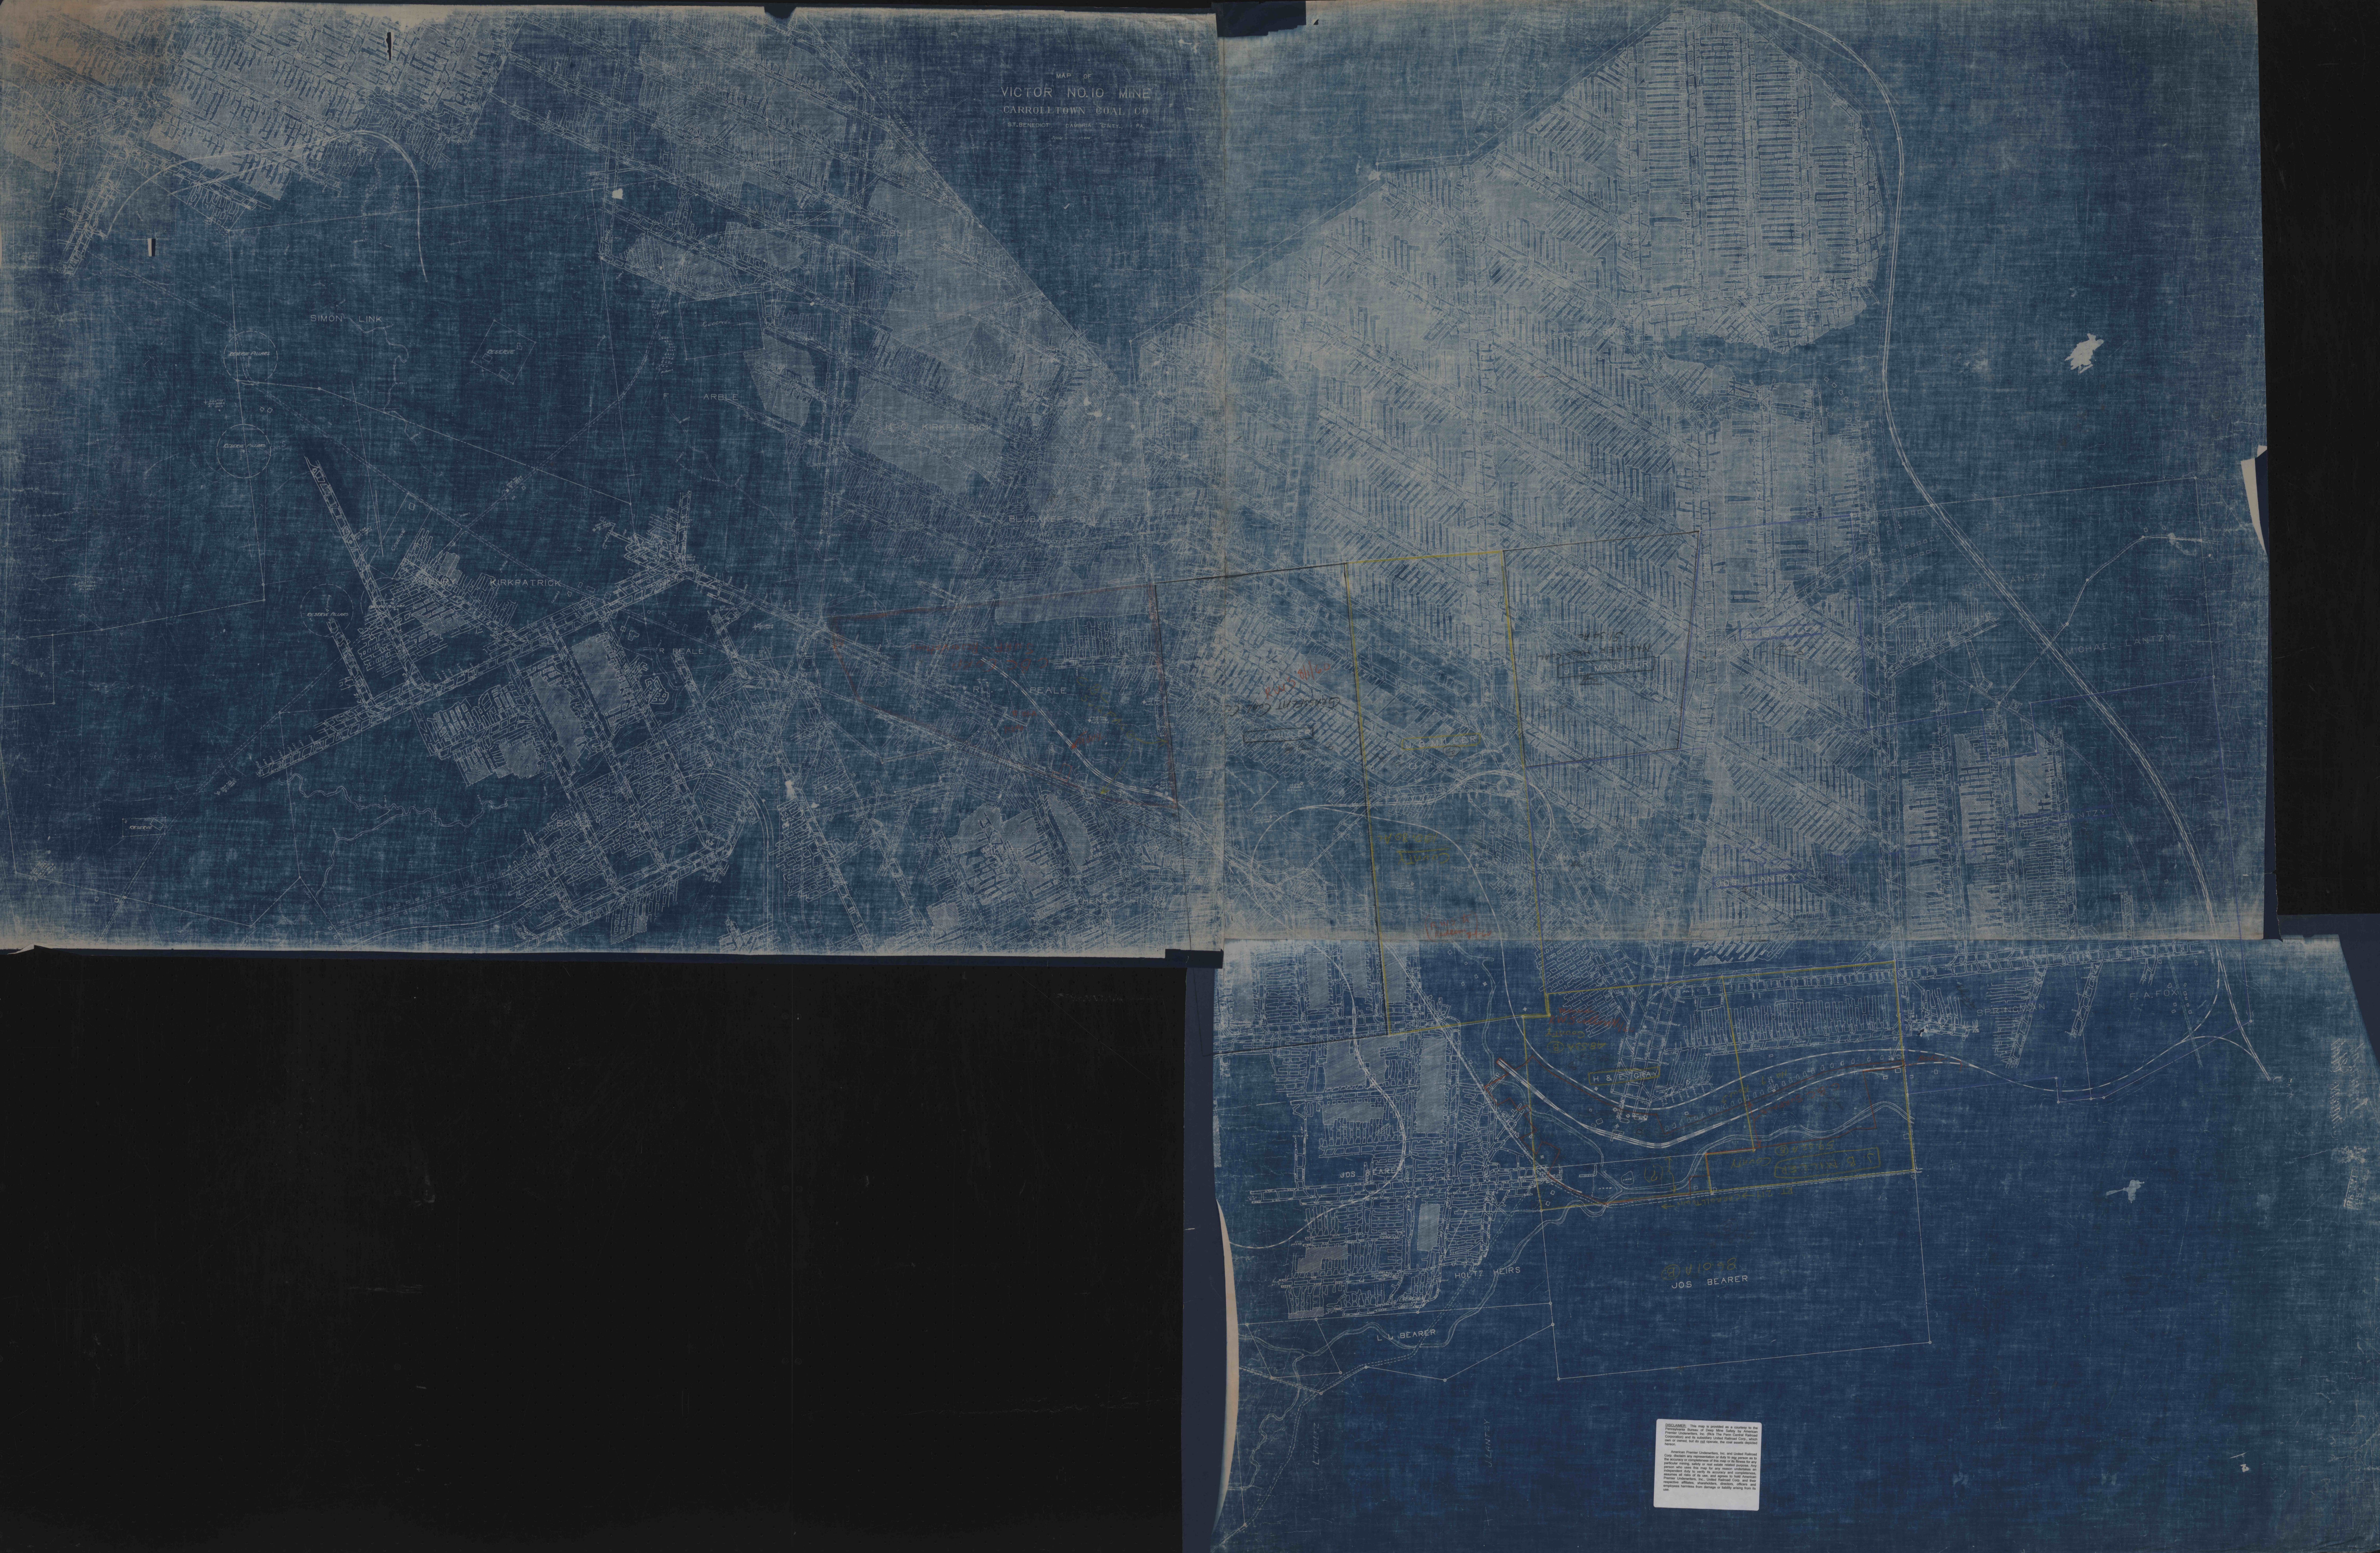

