

I.R. BROWN
BLUBAKER
106.69A.

I.R. BROWN
7.7/6A.


WEBSTER GRIFFITH HRS.
173.391A.

FREDERICK HEINLEIN
78.072A.

JOSEPH MILLER
125.379A.

LIEB-HOPPLE
BLUBAKER
37.74A.

1" = 200'
Barnes-Ticker Co
Bl Seam #15 Mine
Lancashire

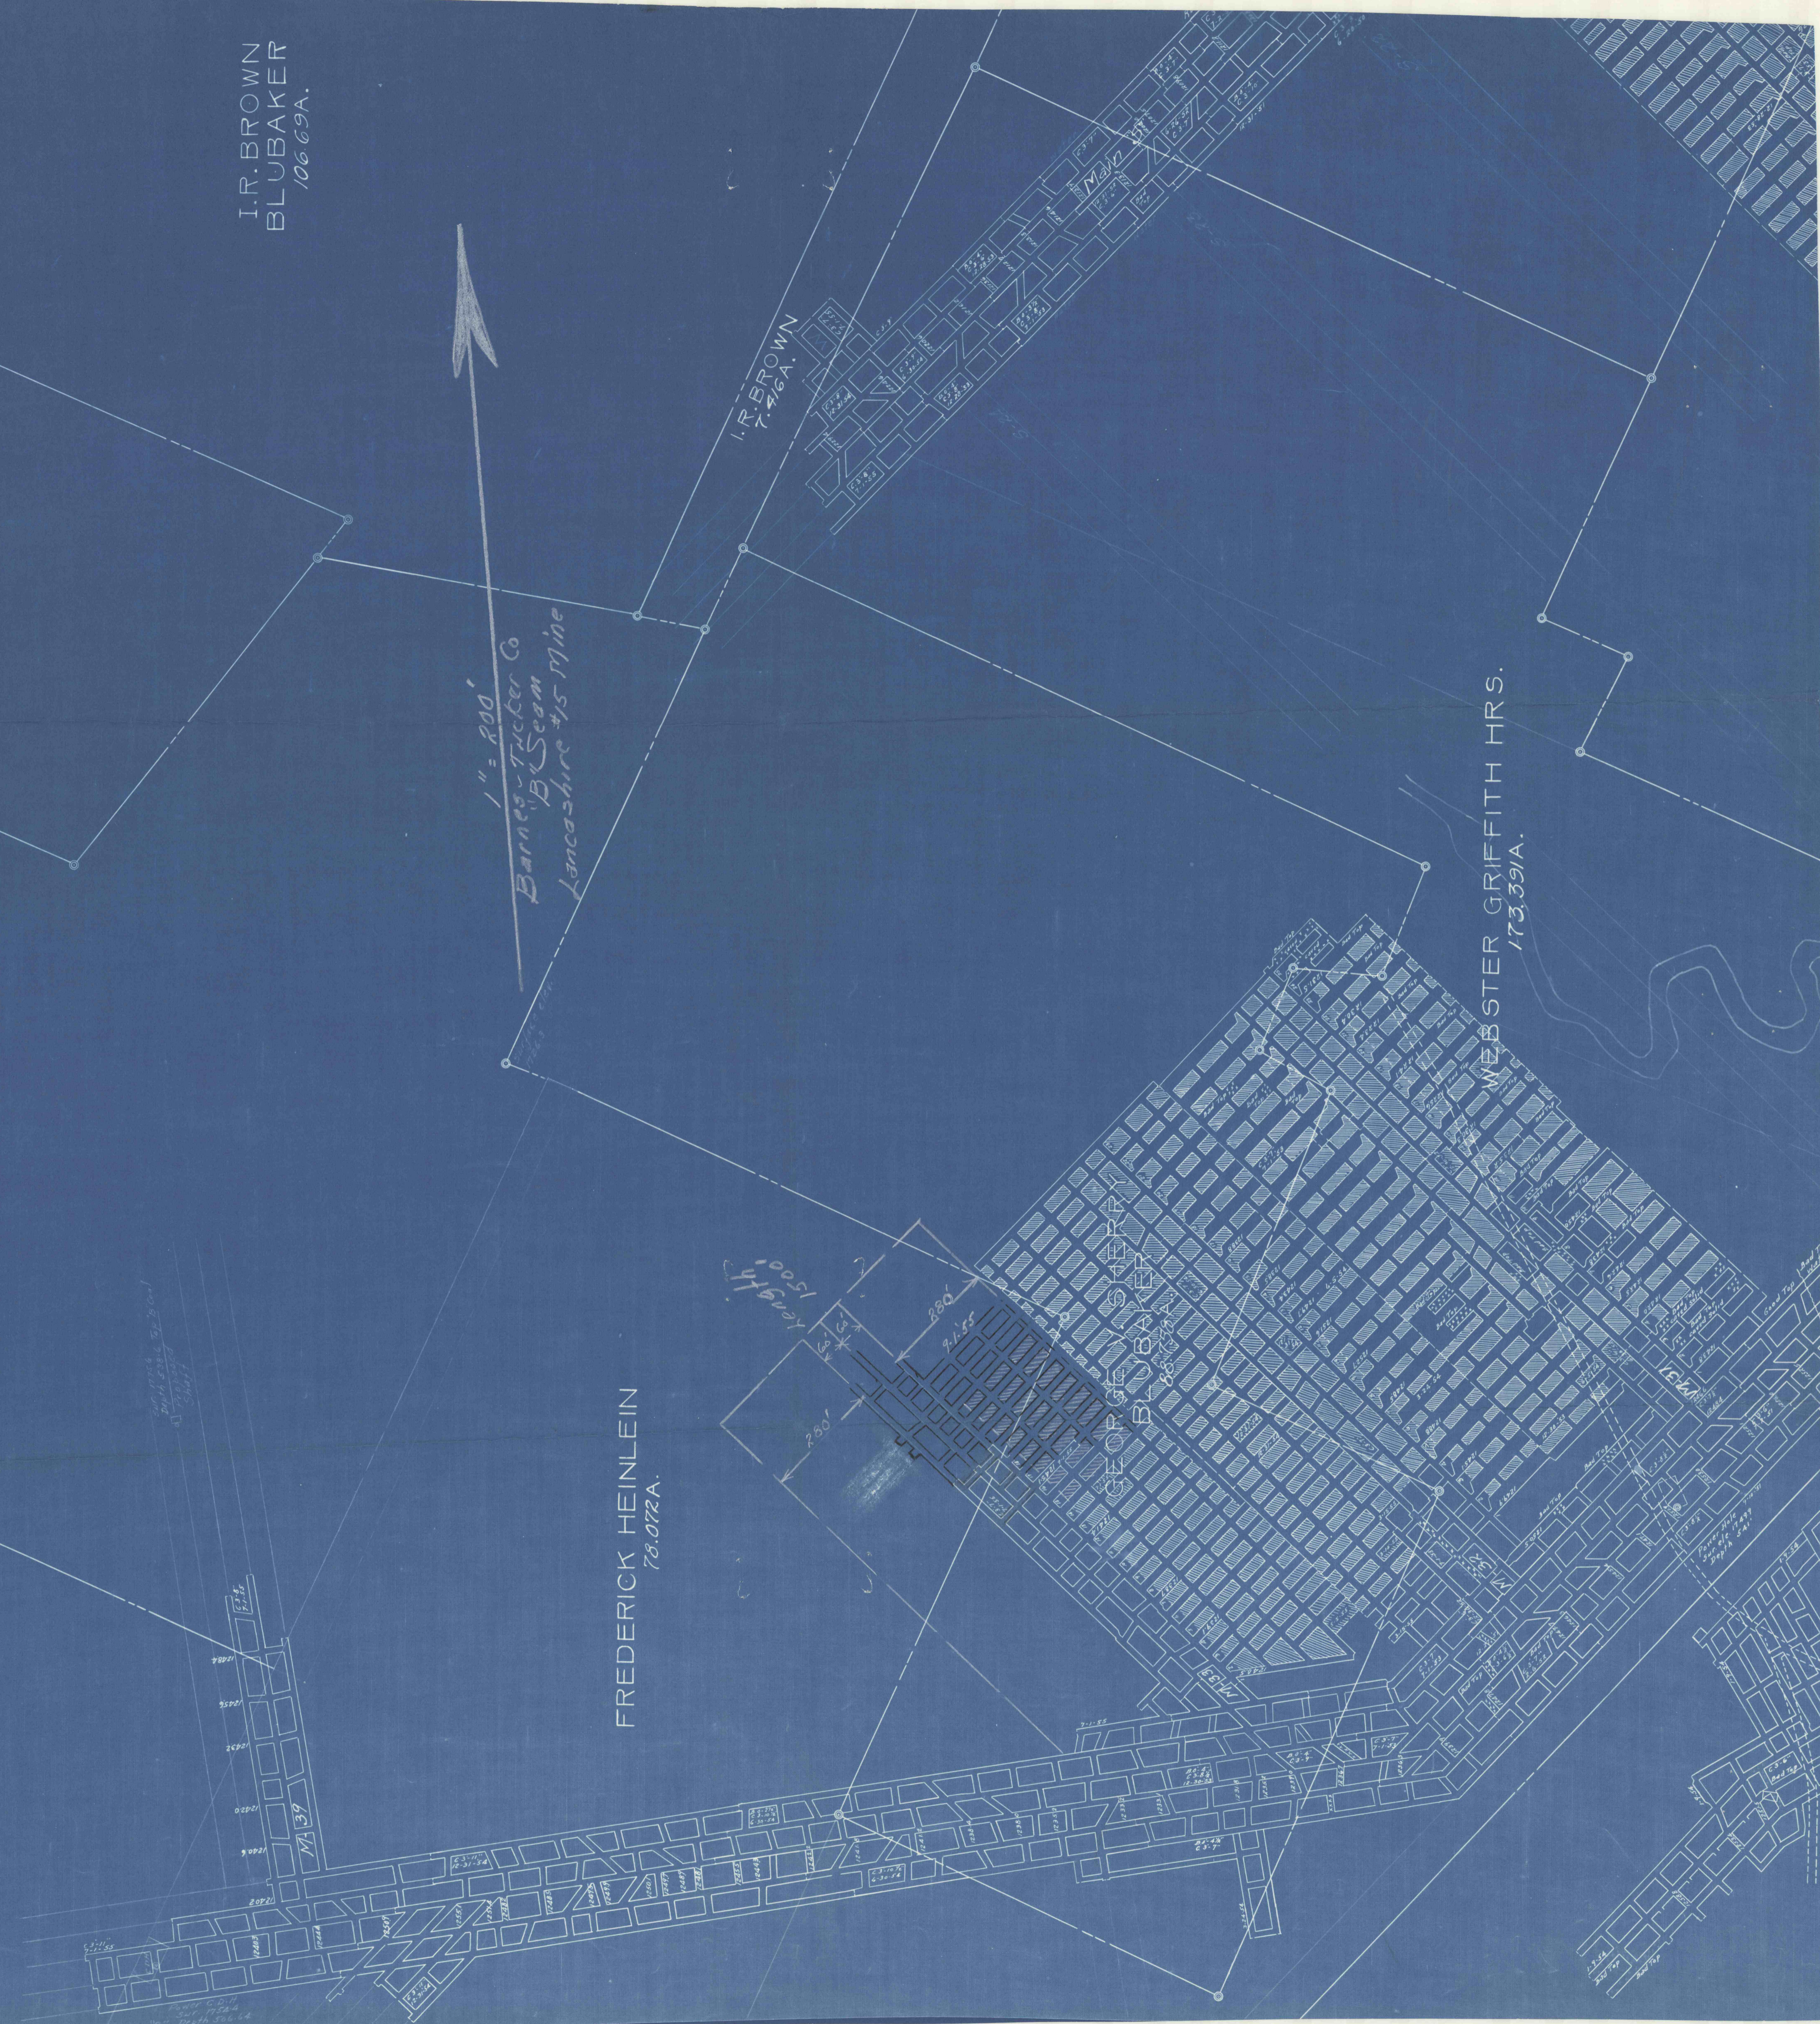

Plan of C. D. H.
for 175A
Top 10" Depth 506.24