



MANOR REAL EST.  
CO.  
"D"



C.B.C. CORP.  
"D"

Mined Out 0.62 AC  
1st 1/2 of 1968


Mined Out 10.84 AC  
1st 1/2 of 1968

C.B.C. CORP.  
"D"

Mined Out 0.37 AC  
1st 1/2 of 1968

MANOR REAL EST. CO.  
"D"

LANCASHIRE  
24 "D"  
1st 1/2 - 1968

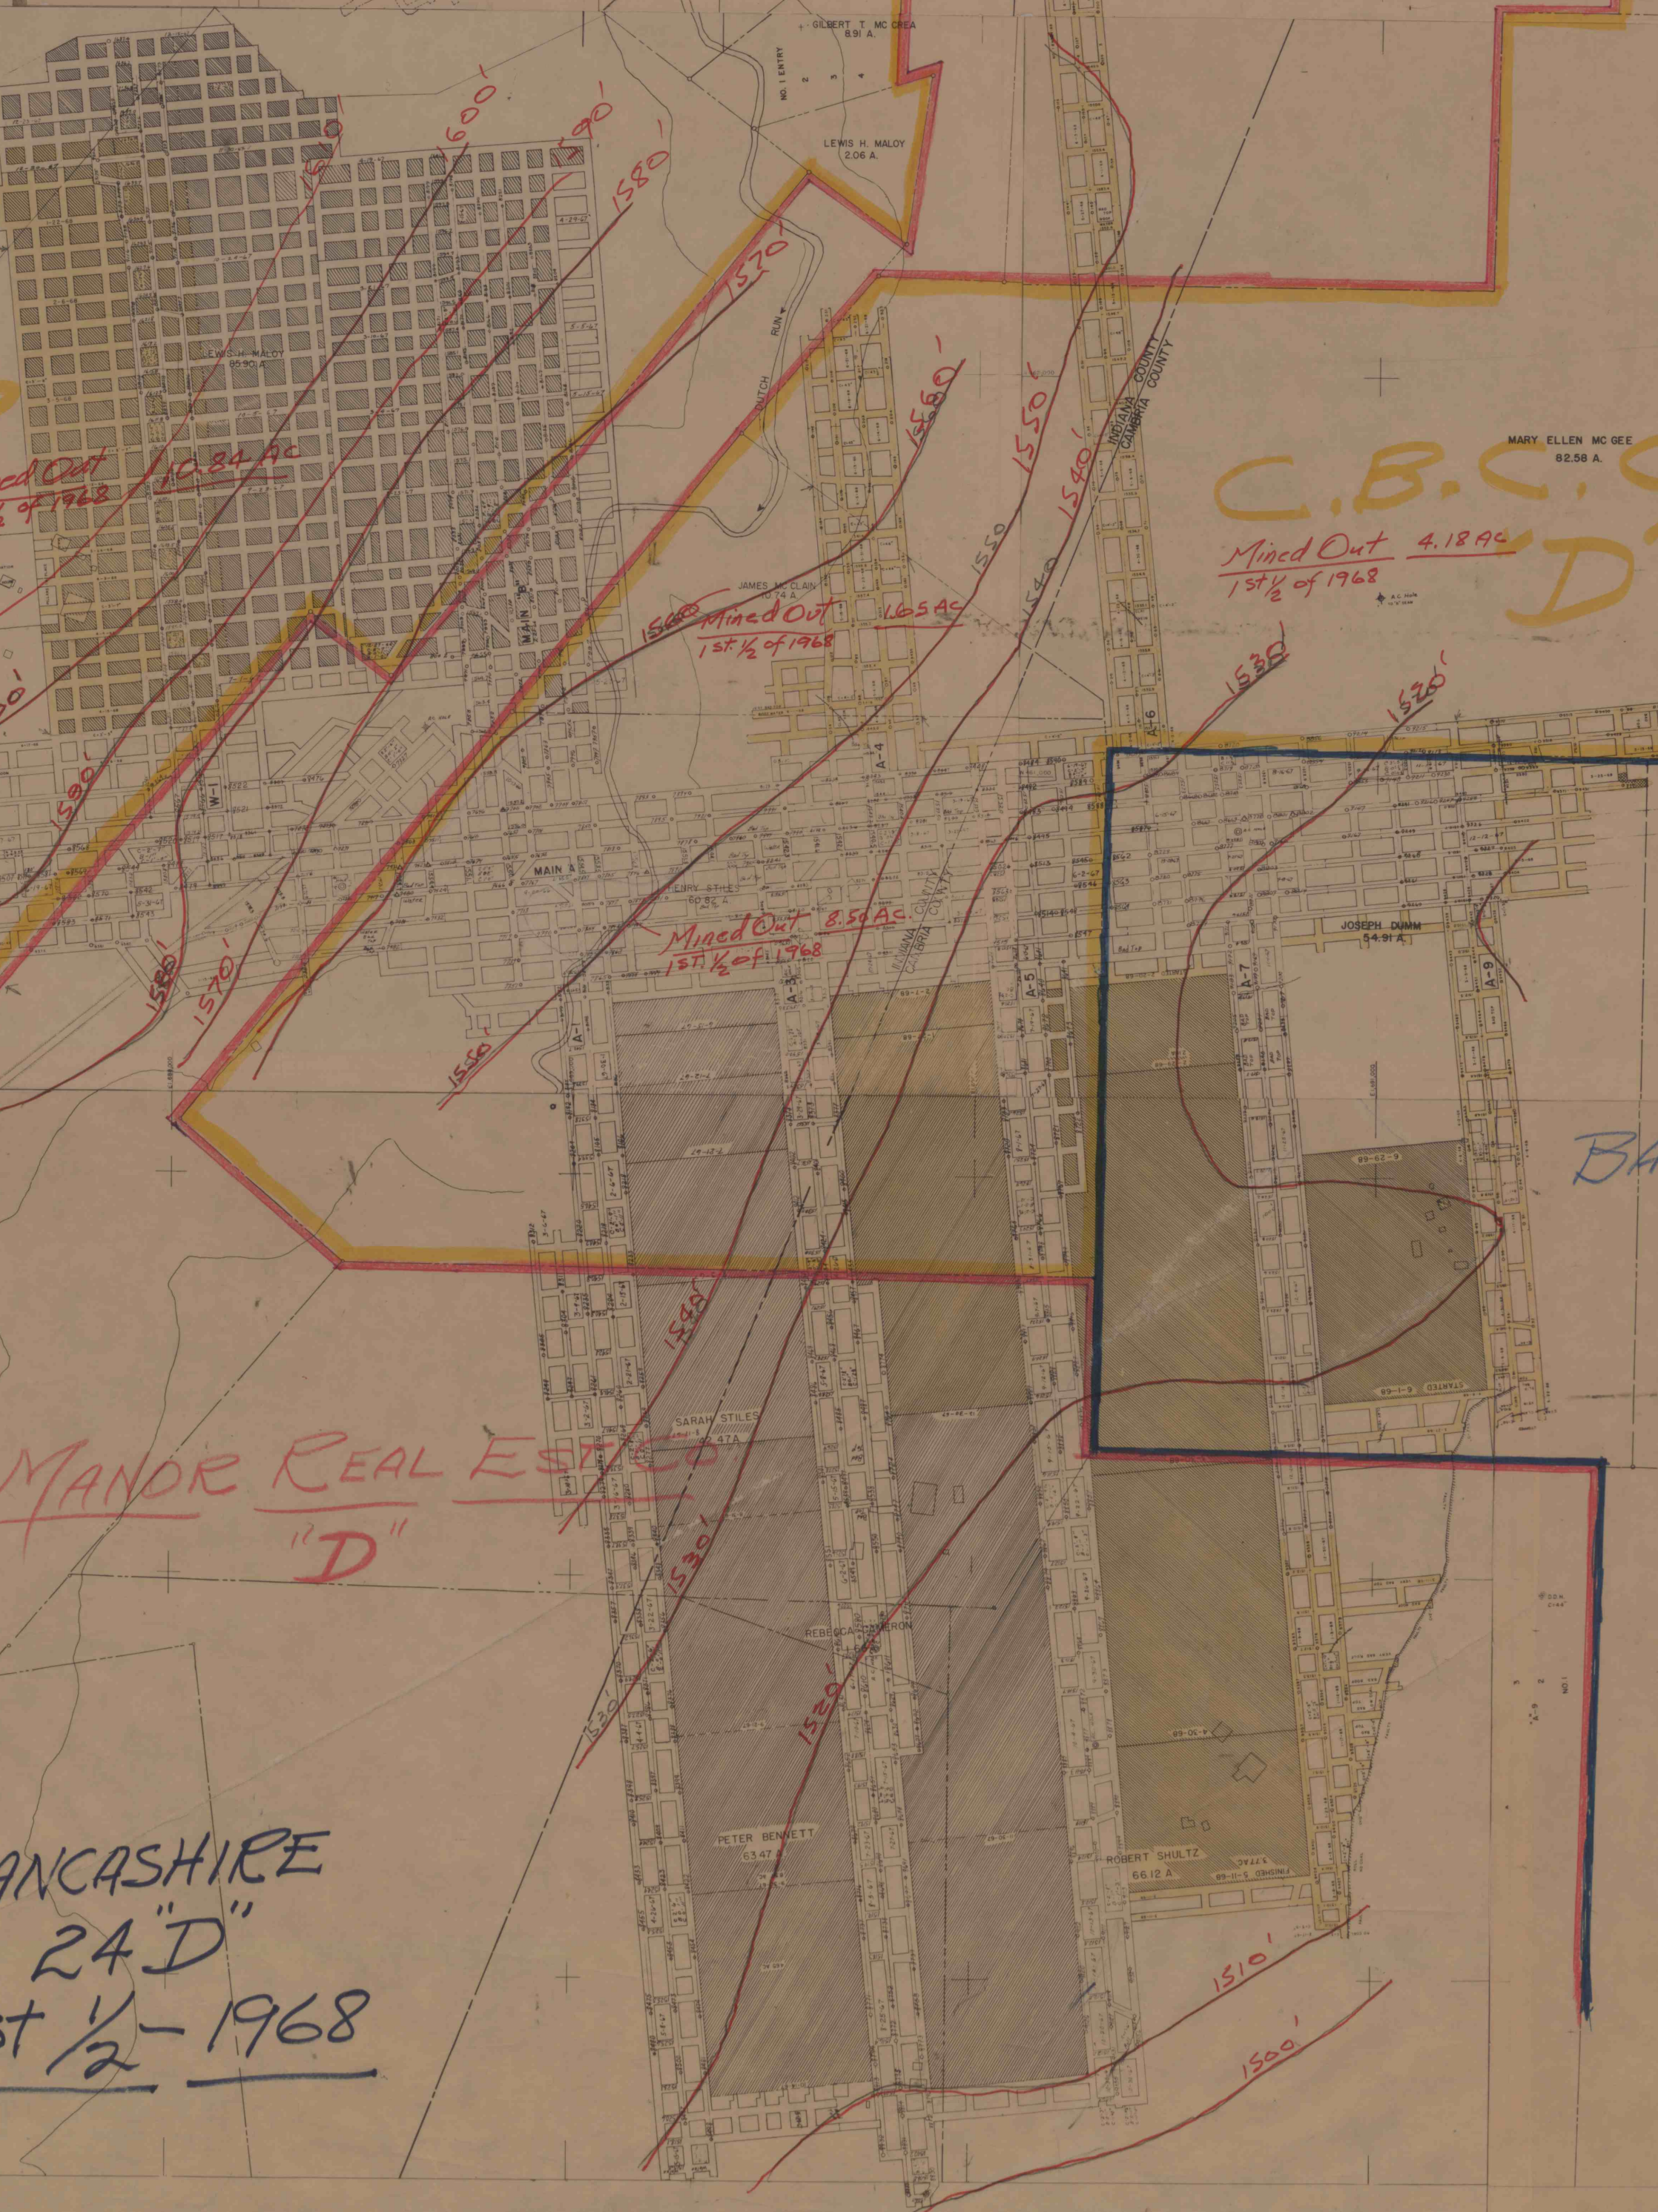

C.B.C. CORP.  
"D"

Mined Out 4.18 AC  
1st 1/2 of 1968

BARNES & TUCKER  
CO.  
"D"

DISCLAIMER: This map is provided as a courtesy to the Pennsylvania Bureau of Deep Mine Safety by American Premier Underwriters, Inc. (APU). The Pennsylvania Bureau of Deep Mine Safety does not warrant, represent, or guarantee the accuracy or completeness of this map or the information contained herein. Any person who uses this map for any reason undertakes an independent duty to verify its accuracy and completeness. American Premier Underwriters, Inc., United Mine Workers, and their respective officers, representatives, directors, agents, and employees are not liable for any damage or liability arising from its use.