


RICH HILL COAL CO.

S. FARBER EST.
37 A. 40 P.

BLUBAKER

JOHN & DAVID LANTZY
197 A. 85 P.

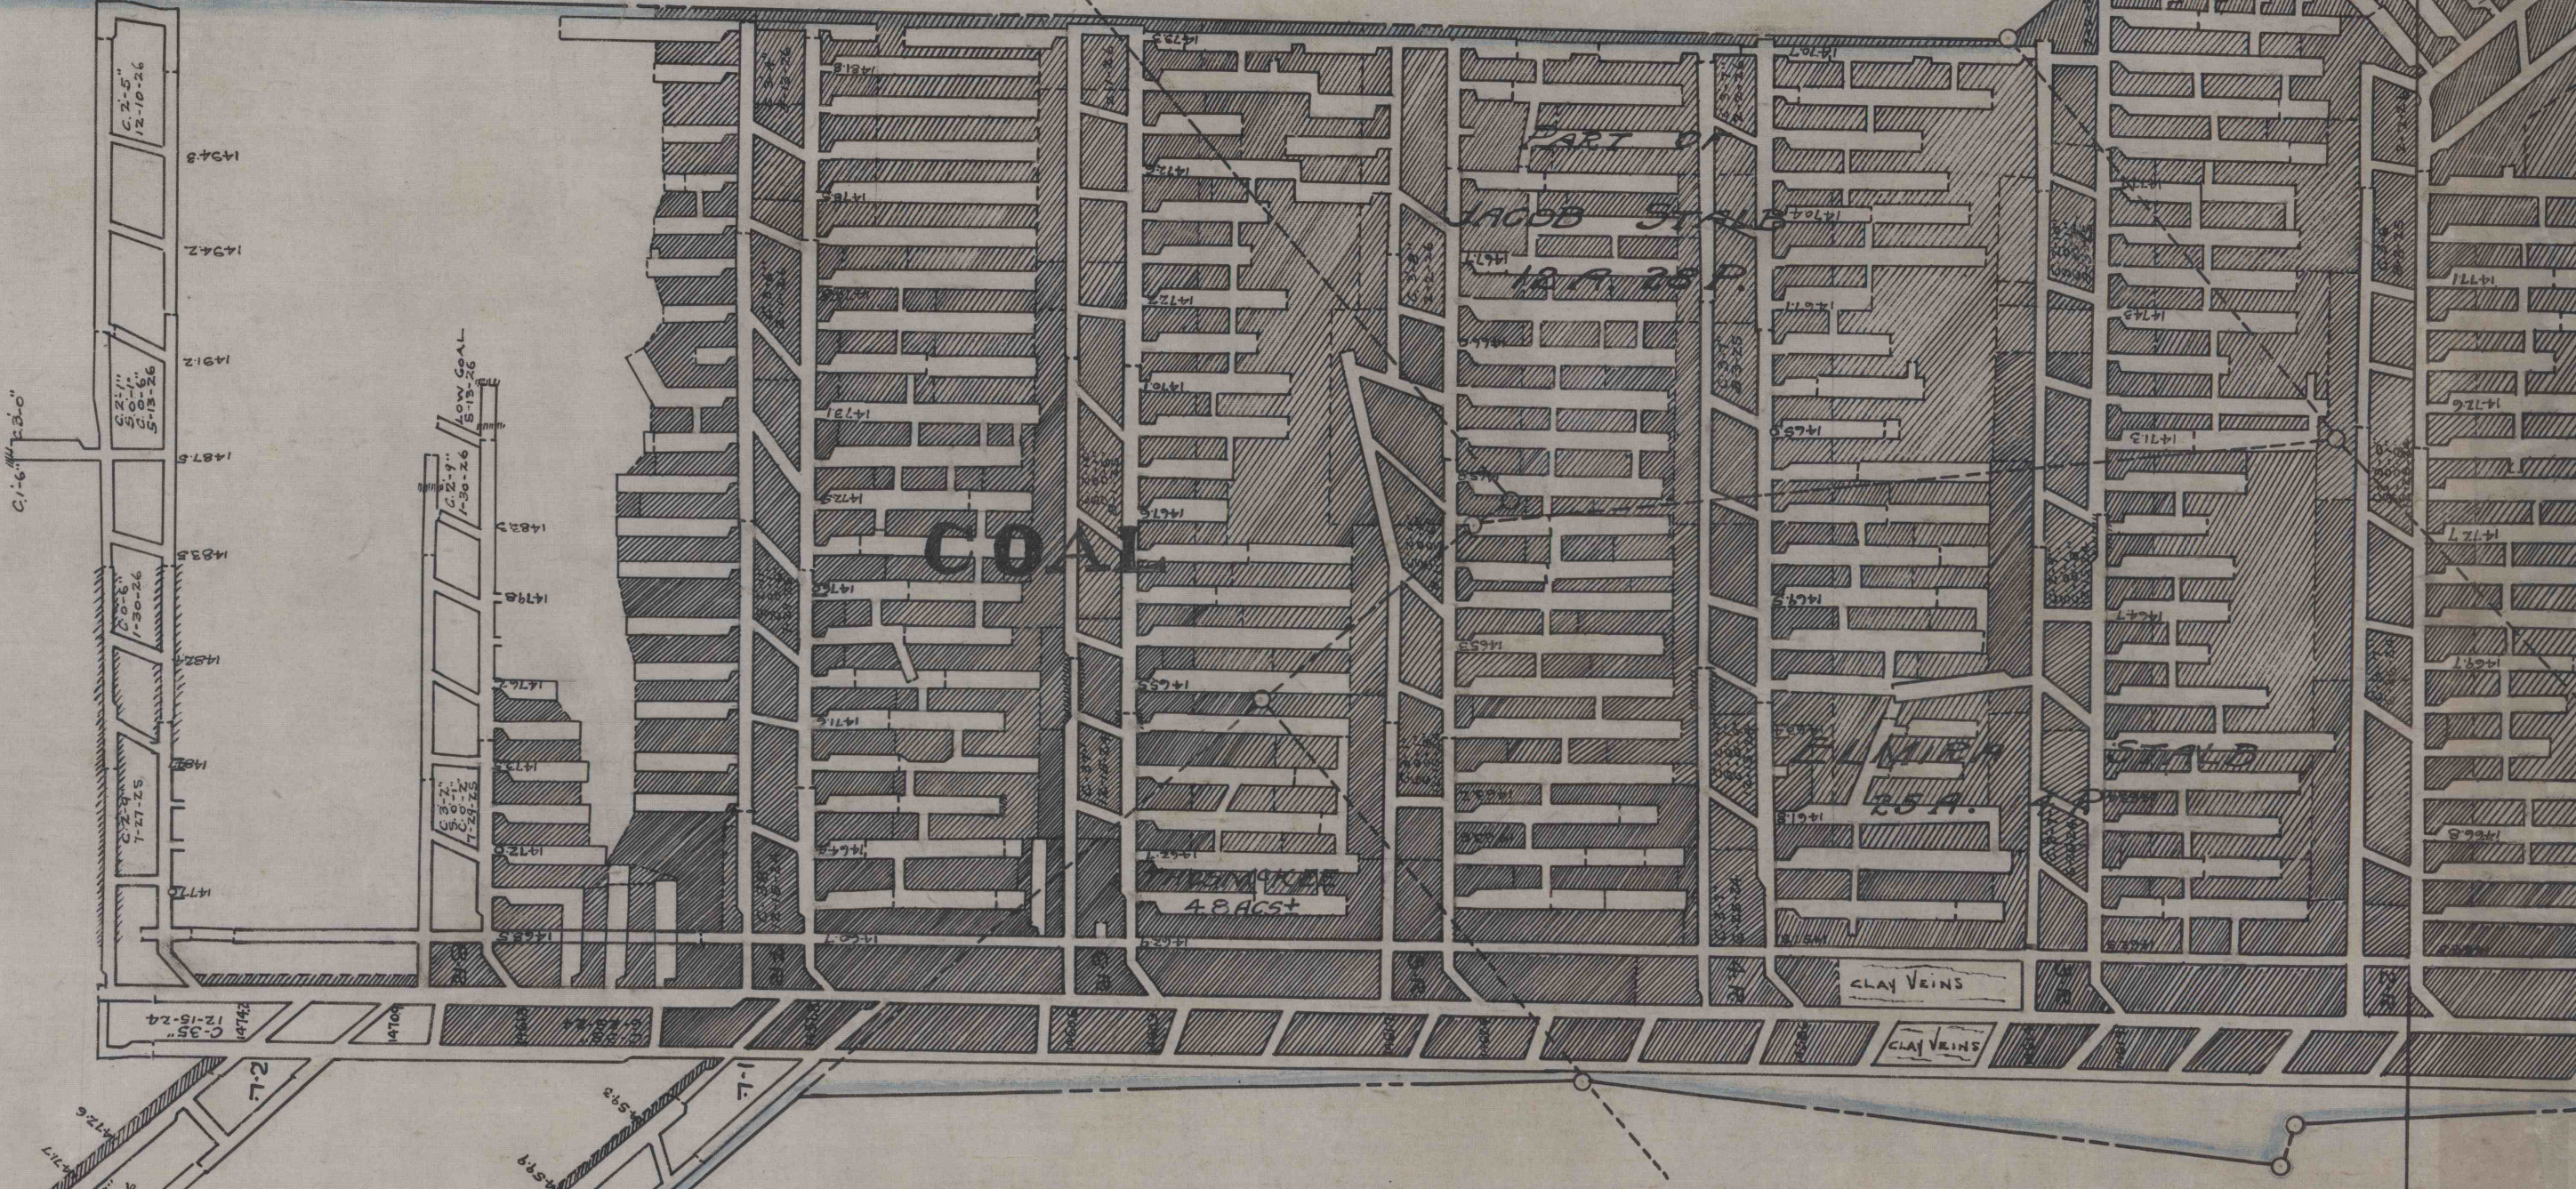

CHERRY TREE

COAL

CO.

CHERRY TREE

COAL

67B

67B

Jan 18
1880