


Reduce Maps F-4, G-5, & G-6 From 1"=100' to 1"=200' negatives
Strip into furnished composite negative -
Make 1 film positive

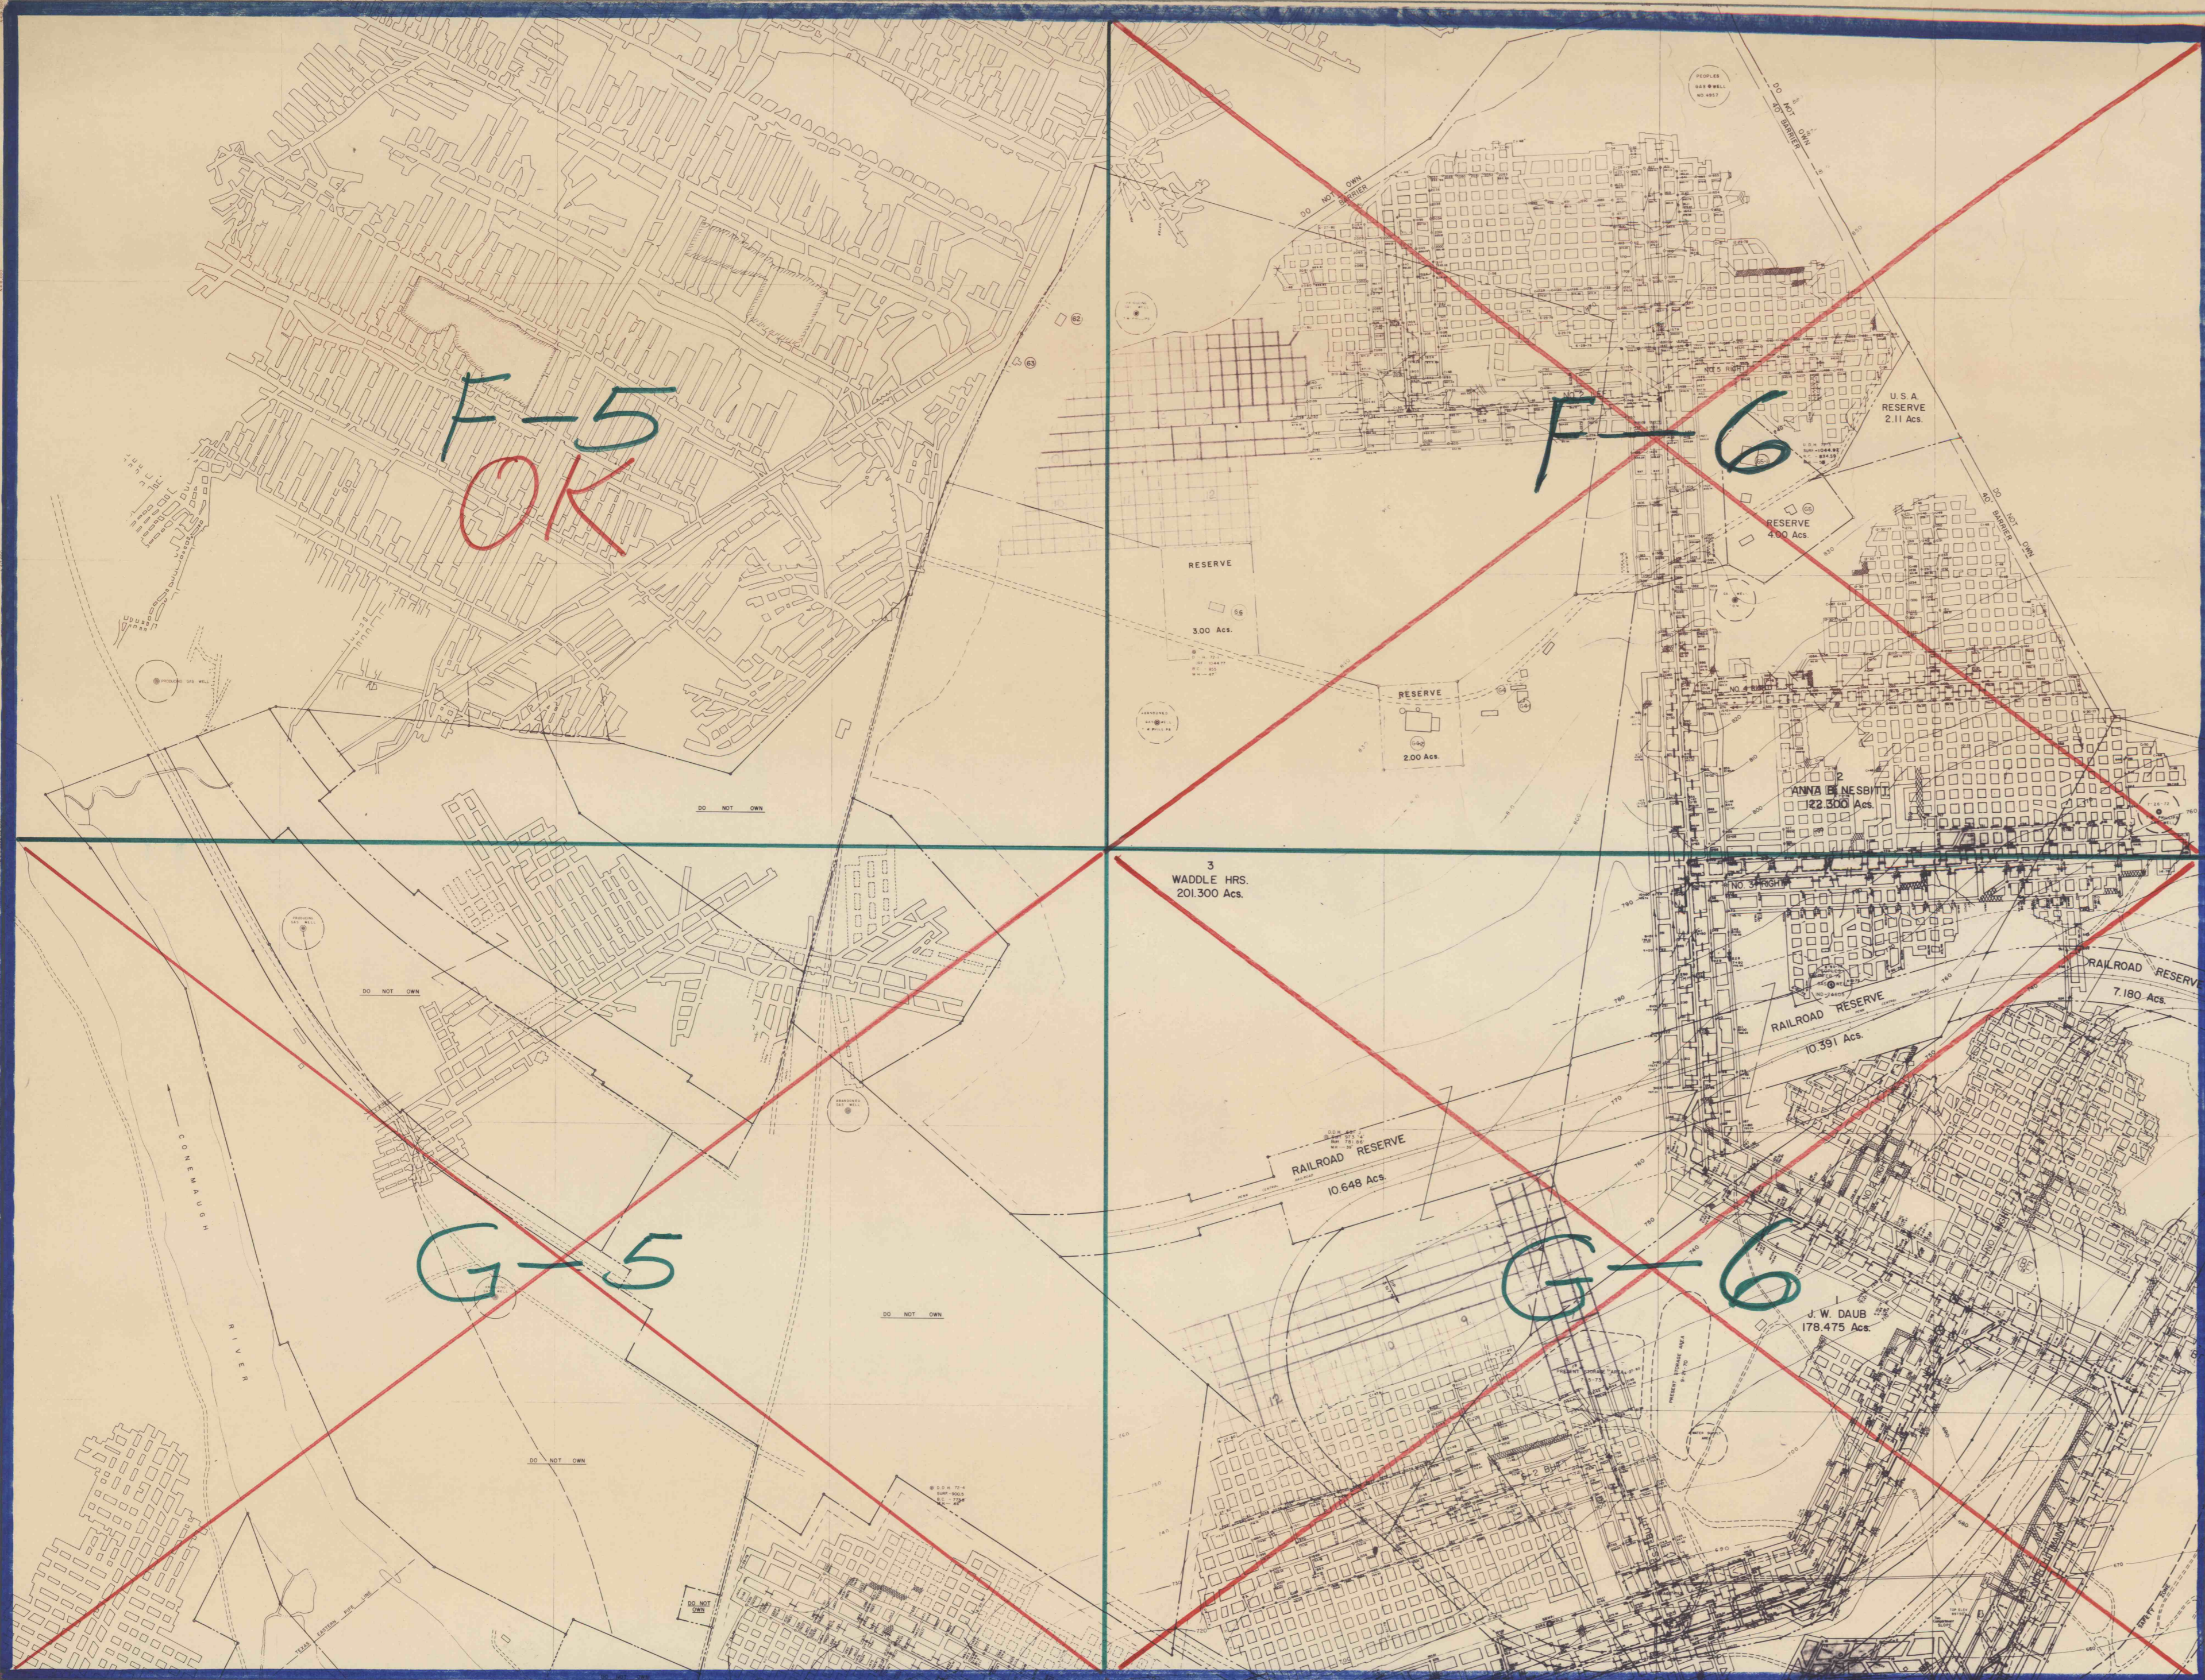

Reduce Maps J-7, J-8, K-7, & K-8 From 1"=100' to 1"=200' negatives
Strip into ~~negative~~ composite negative -
Make 1 film positive