
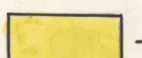
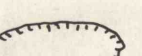
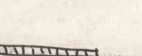


J. HOUCK


J. KIRKLAN




LEGEND

-  - MINED OUT
-  - PROBABLE LOST COAL (BY J. MARSHALL)
-  - DISTURBED CONDITION (CONTINUOUS BOT. ROLLS)
-  - ROOF & BOTTOM ROLL TOGETHER (SEE "A")

TYPICAL COAL SECTIONS IN DISTURBED CONDITION

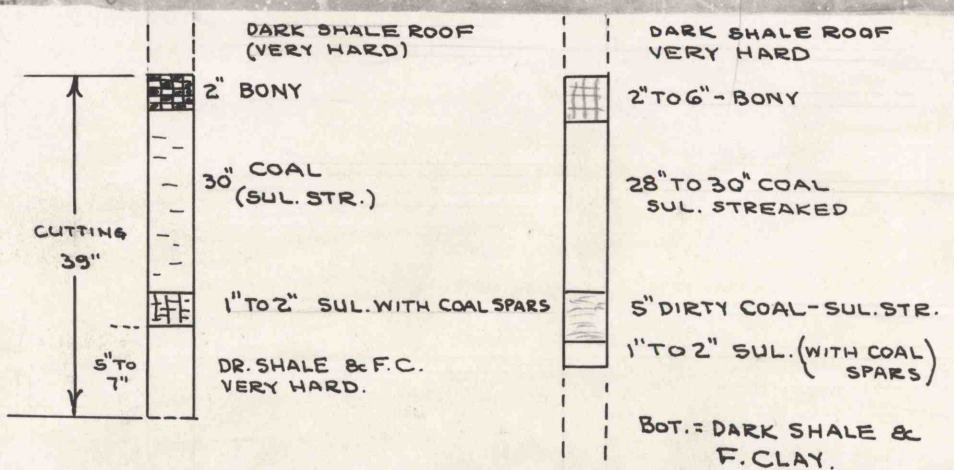

Roof & Bottom Roll "A"

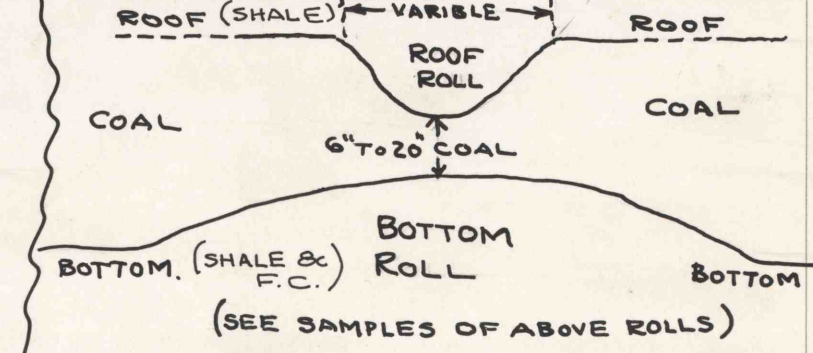

ABOVE DATA COMPILED FROM INSP 4-14-60 BY J. FAKO-I.K.G. M.BAXTER-C.B.C. ADDITIONAL INF. BY J. MARSHALL