

**GLYMER BORO**

MAP SHOWING STRIP WORKINGS OF THE  
 MORRONE COAL CO.  
 CHERYHILL TWP INDIANA CO, PA  
 B. SEAM SCALE 1" = 200'  
 SURVEYED DECEMBER 14, 1921 BY THOMAS HOWARTH

JOS. HINES  
 C.B.C. CORP - FEE


JOS HINES  
 C B C CORP - FEE

W. KEPHART 1.2 A  
 I. J. DEYARMINE 1.9 A

JAMES MCKENDRICK  
 174.2 A

JOHN MCKENDRICK  
 294.77 A  
 2.53 A RES  
 292.41 A

MARG MYERS  
 116.9 A

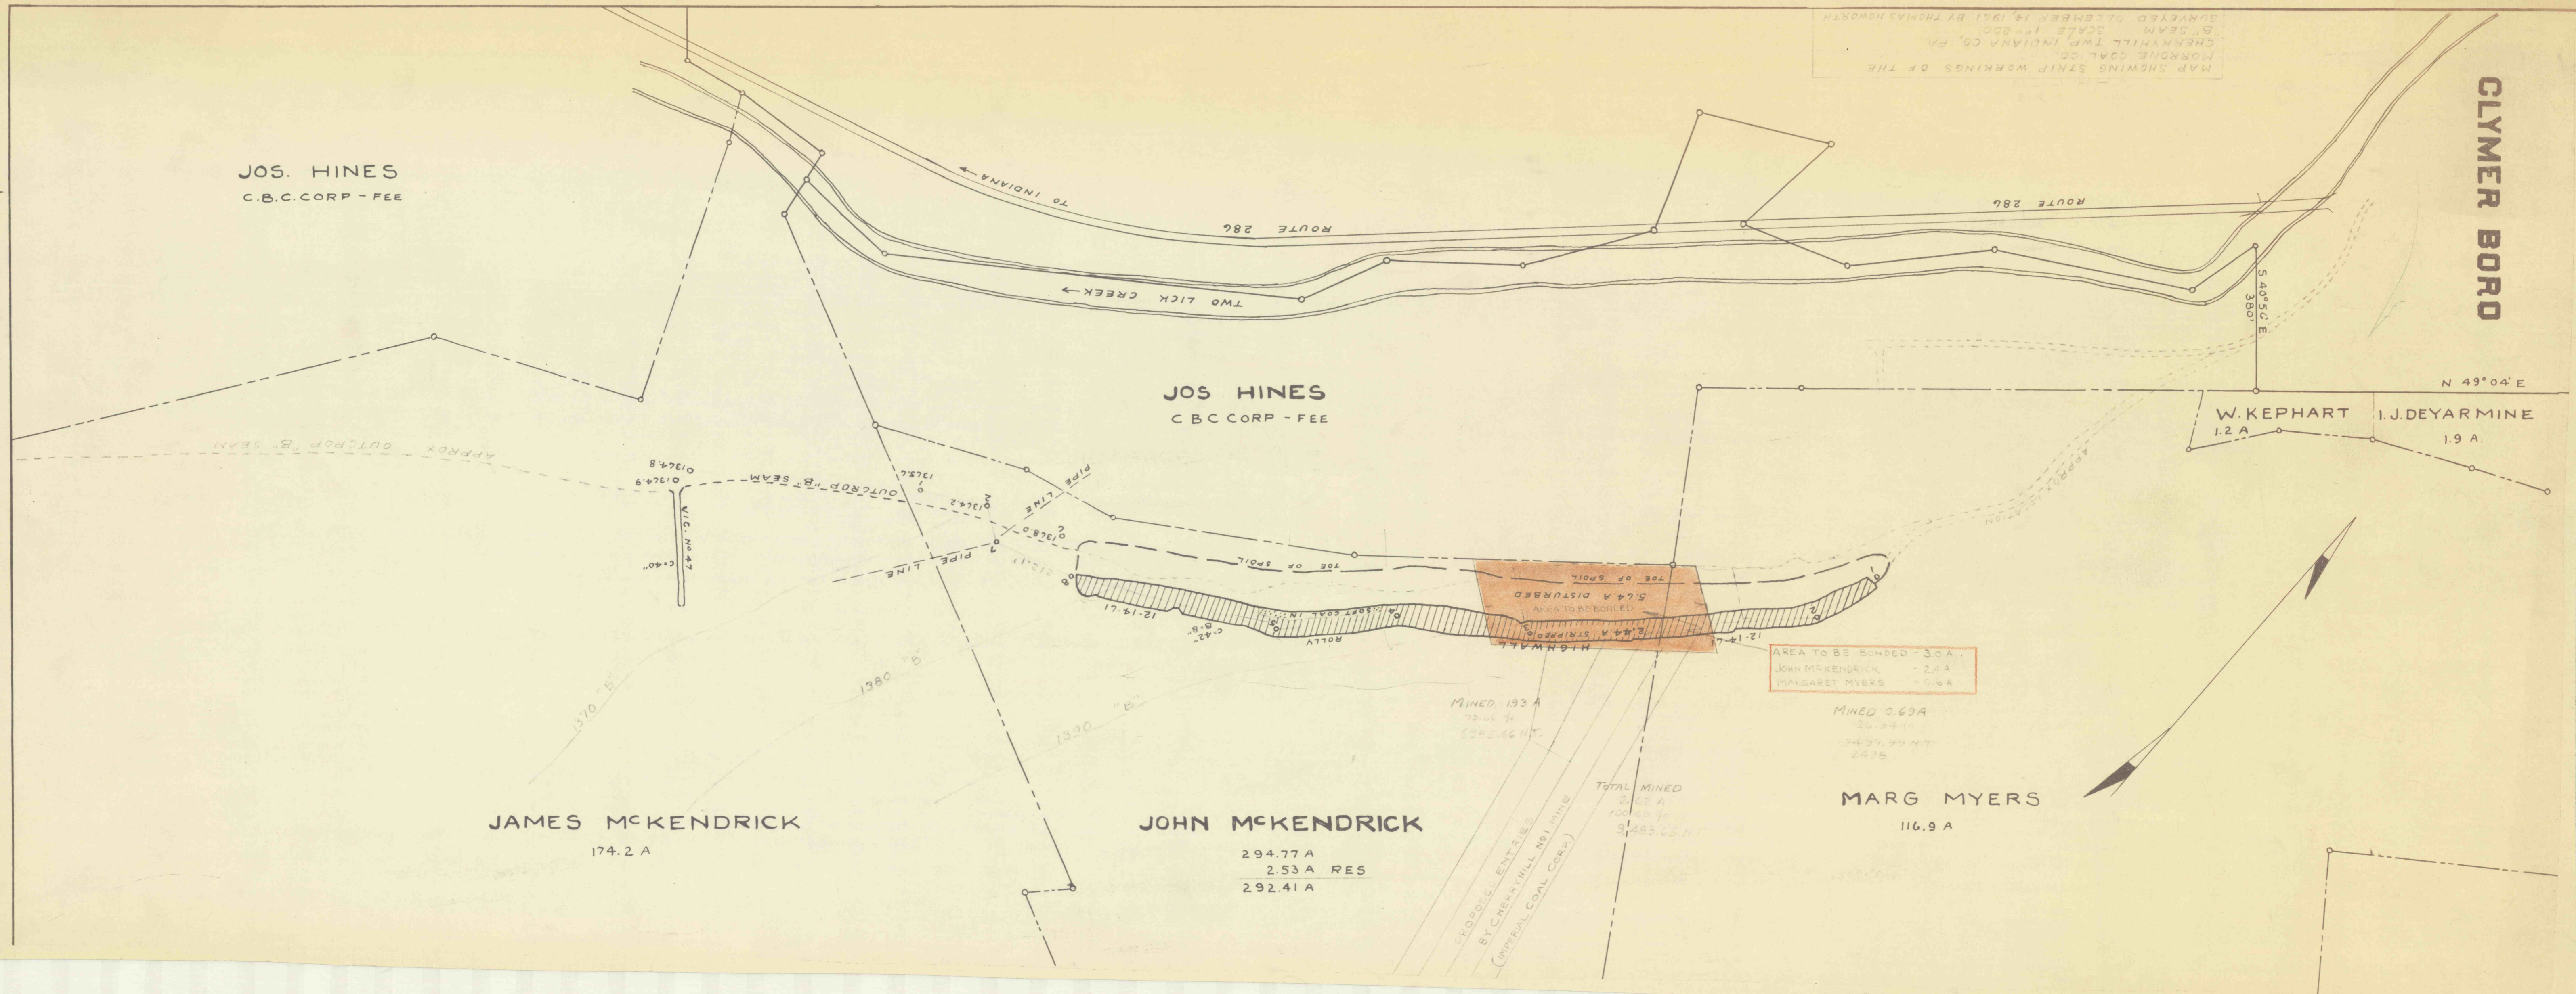

AREA TO BE BOUNDED - 30A  
 JOHN MCKENDRICK - 2.4A  
 MARGARET MYERS - 0.6A

MINED 0.69A  
 25.24 1/2  
 2475

TOTAL MINED  
 2.62 A  
 100.00 1/2  
 9,483.25 H.T.

MINED, 193 A  
 73.66 1/2  
 6243.66 H.T.

PROPOSED ENTRIES  
 BY CHERYHILL NO 1 MINE  
 (IMPERIAL COAL CORP)

