


Scale 1"=200'

B-158
B-278
M

NOV 26 1909

WALNUT COLLIERIES Nos 1, 3 & 4 WALNUT COAL COMPANY BARNESBORO PA

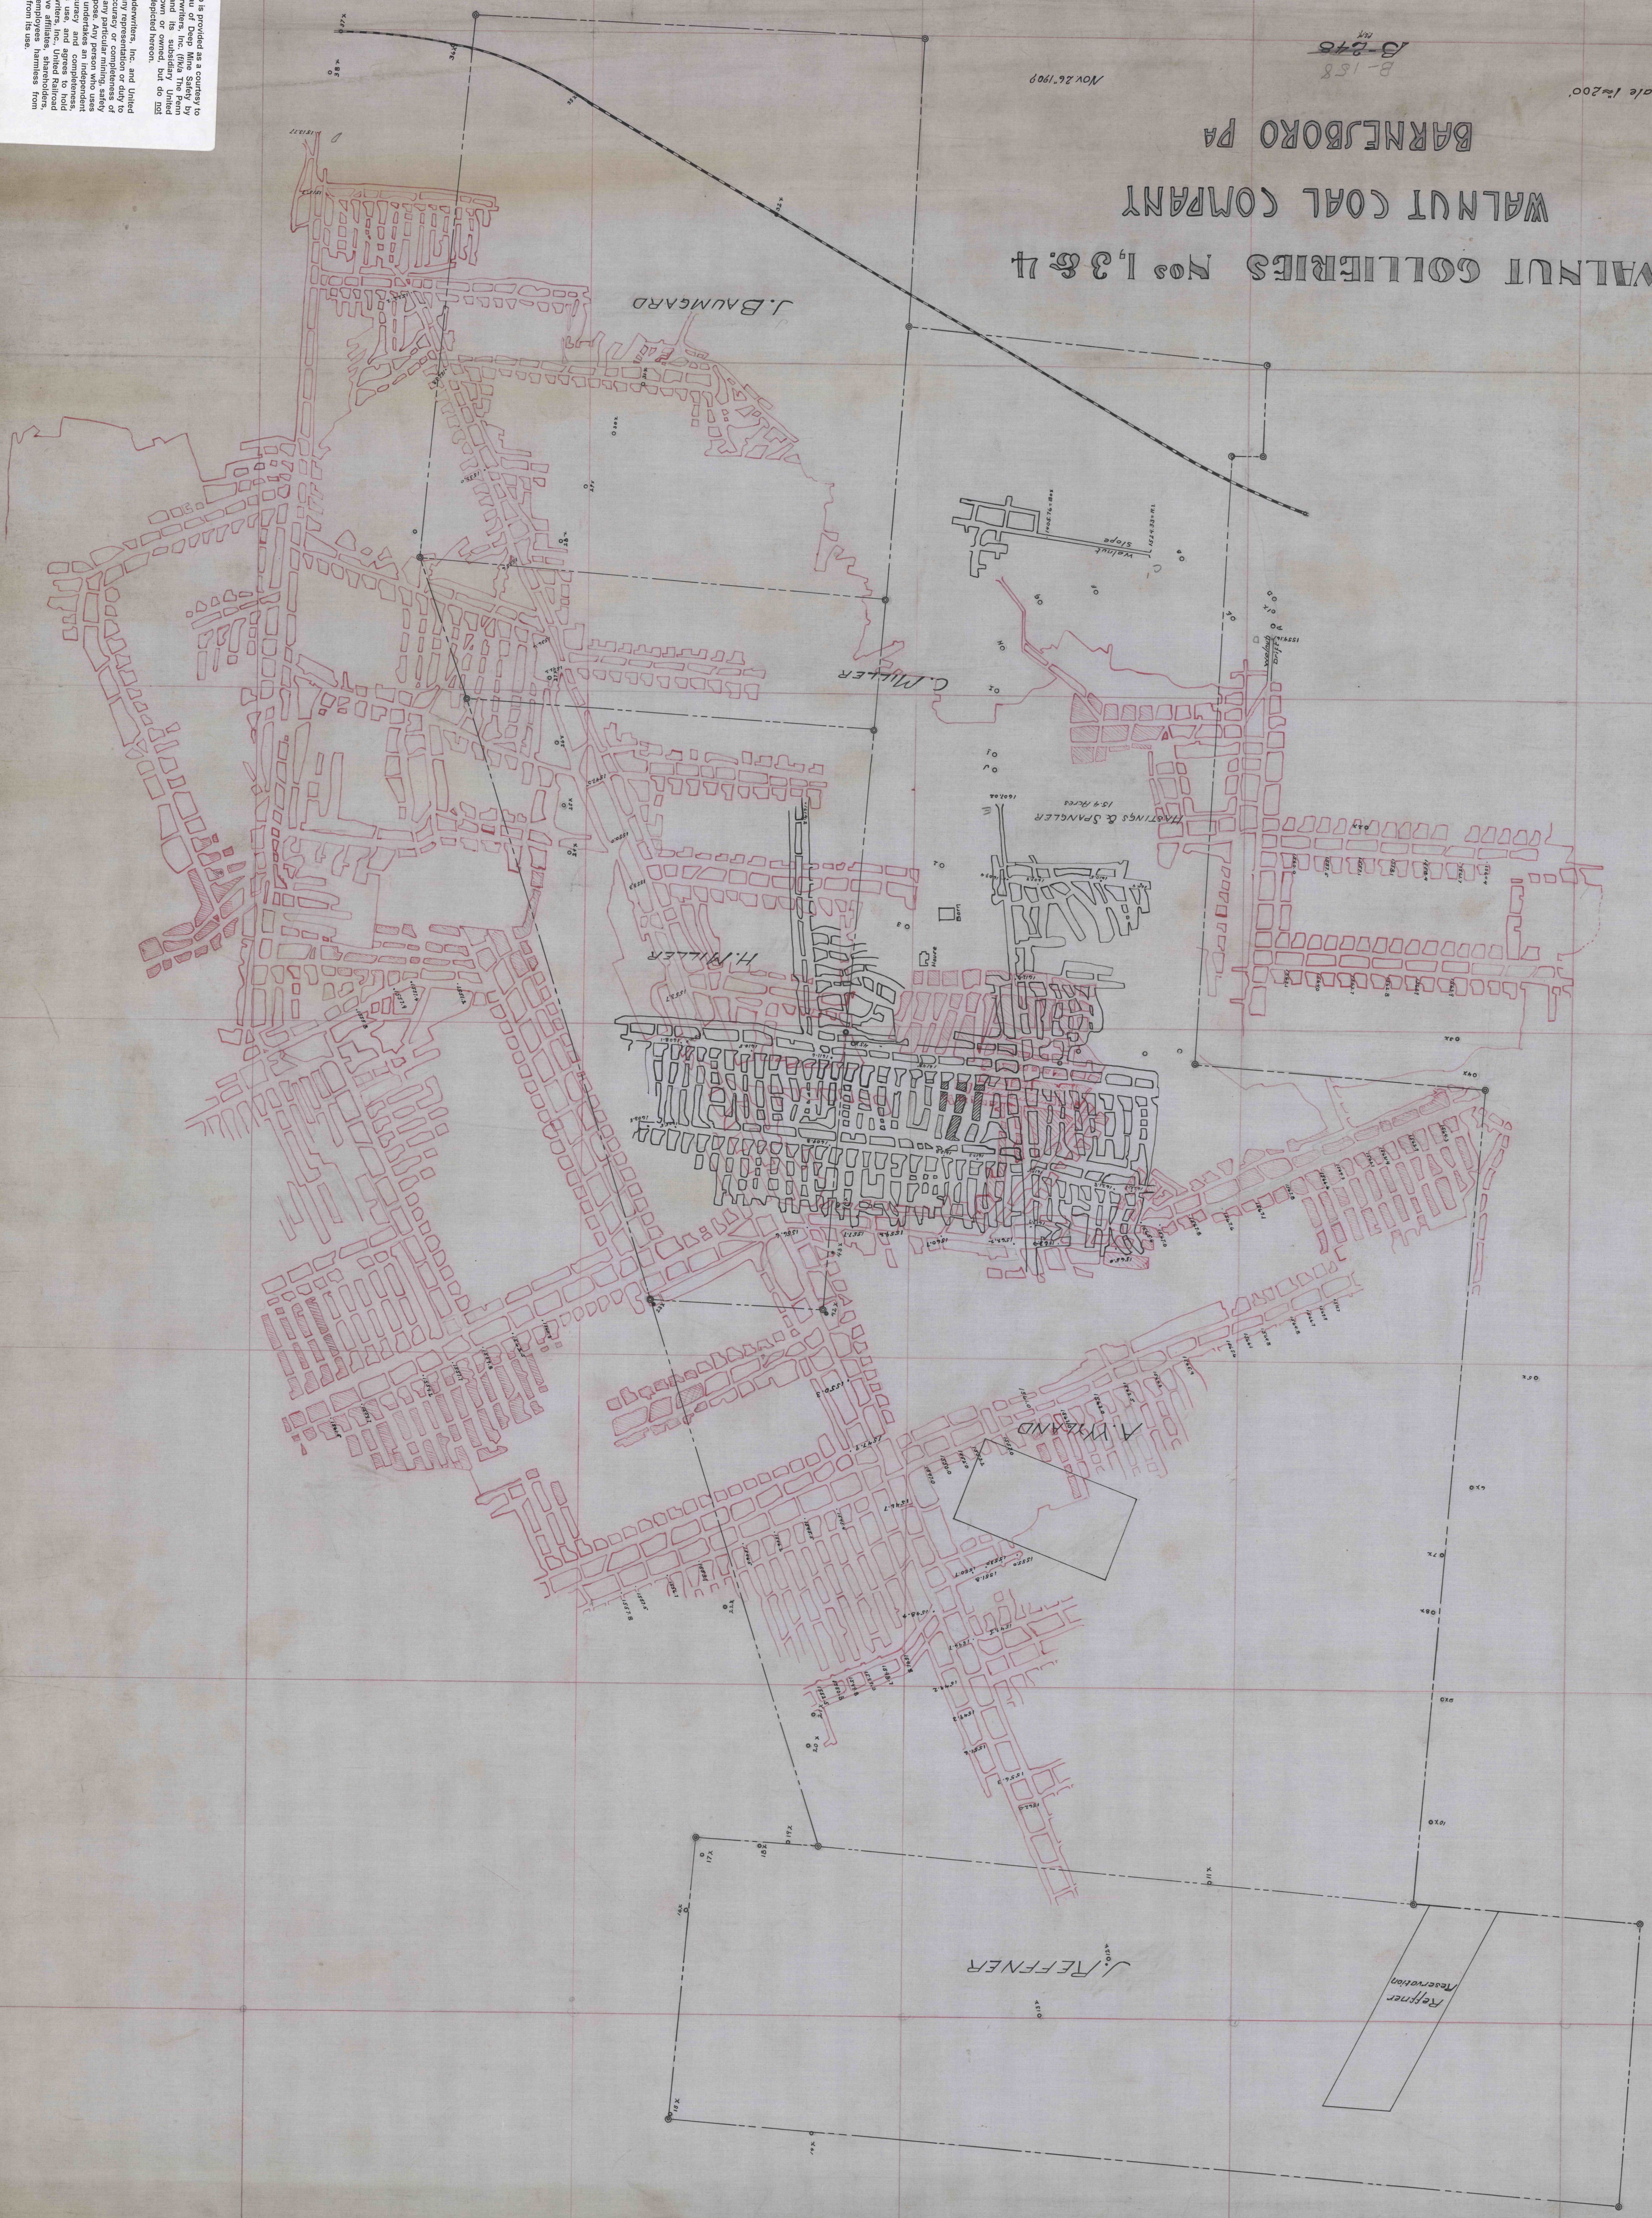

DISCLAIMER: This map is provided as a courtesy to the Pennsylvania Bureau of Mines and is not intended to be used as a legal document. The Pennsylvania Bureau of Mines and the American Premier Underwriters, Inc. (then The Penna. Coal & Oil Co.) are not responsible for any errors or omissions on this map or for any use of the map for purposes other than those intended. American Premier Underwriters, Inc. and United Railroad Corp. disclaim any representation or duty to any person who uses this map or for any use of the map for purposes other than those intended. Any person who uses this map or for any use of the map for purposes other than those intended, does so at their own risk and assumes all risks of its use, and agrees to hold American Premier Underwriters, Inc., United Railroad Corp. and their successors, heirs, assigns, agents, officers and employees harmless from any and all claims, damages or liability arising from its use.