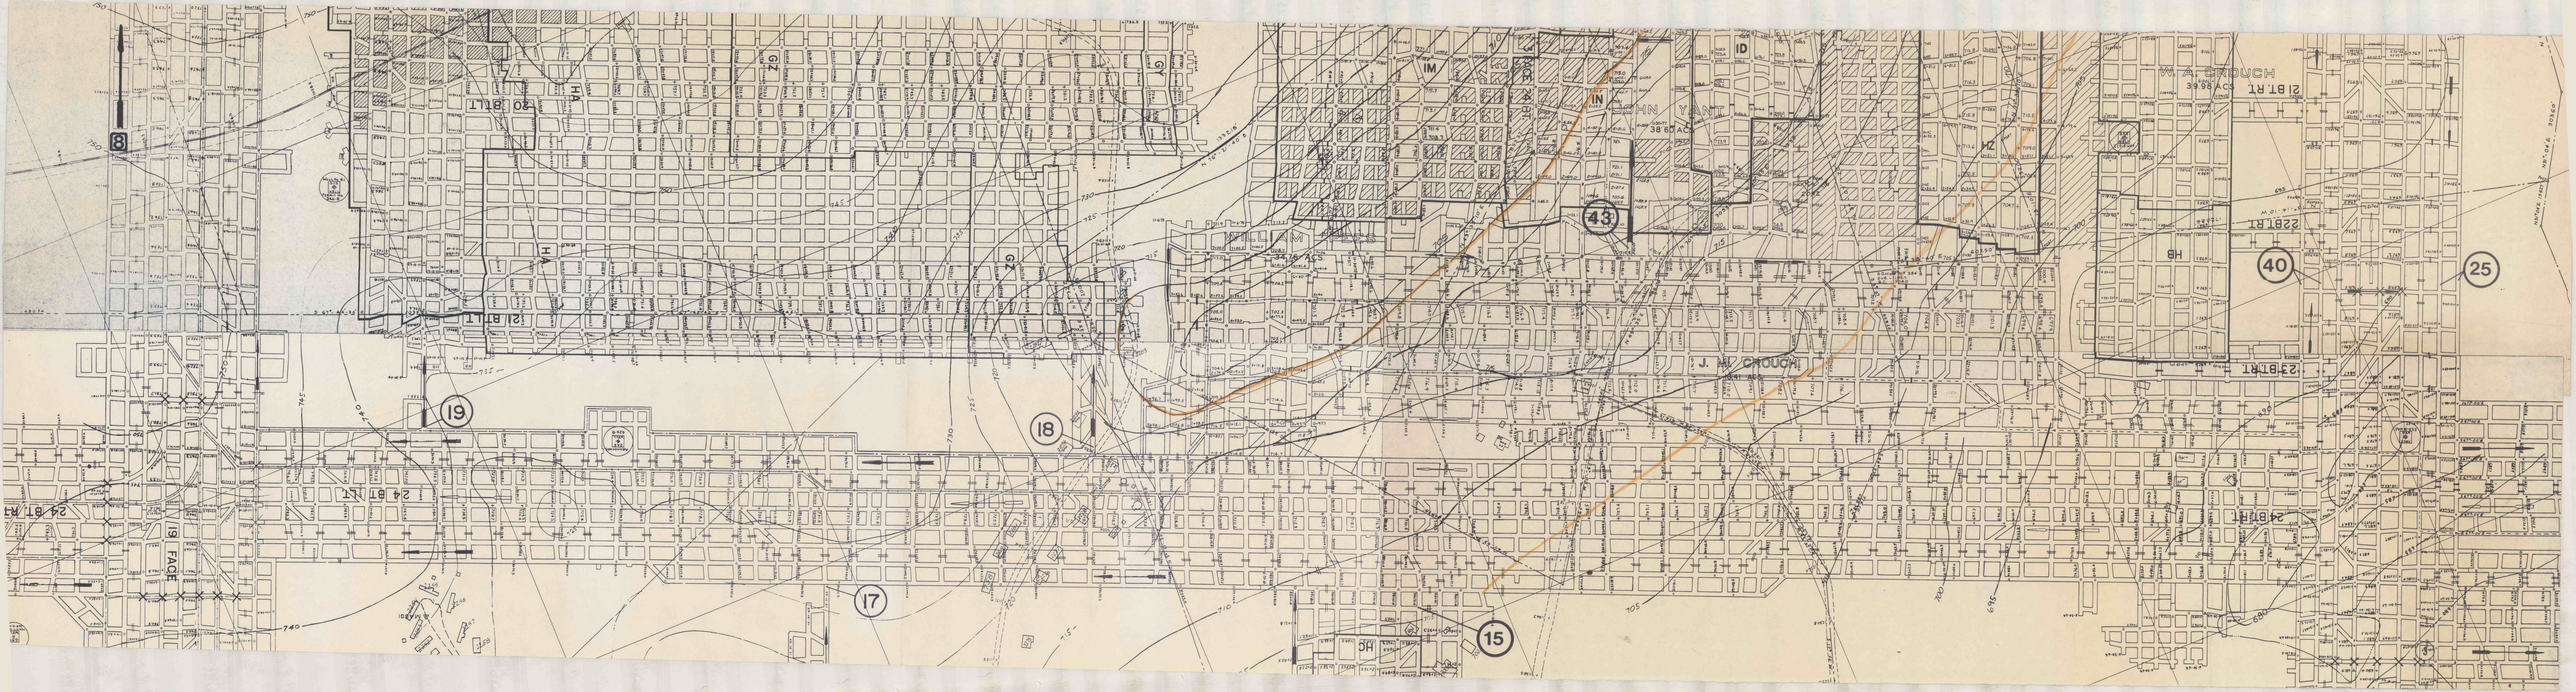

W. A. CROUCH
39.98 ACS
21 BT RT
22 BT RT
23 BT RT
24 BT RT
20 BT LT
21 BT LT
24 BT LT
19 FACE
J. M. CROUCH
WILLIAM
JOHN YANT
38.60 ACS
HA
GZ
GY
IM
IN
ID
HZ
HB
8
15
17
18
19
25
40
43