


1-506

FIT TO K-5205

Checked by C. J. Pittsburgh Aug 22, 1924
Made up with 2-14

FIT TO K-5071

FIT TO K-5067

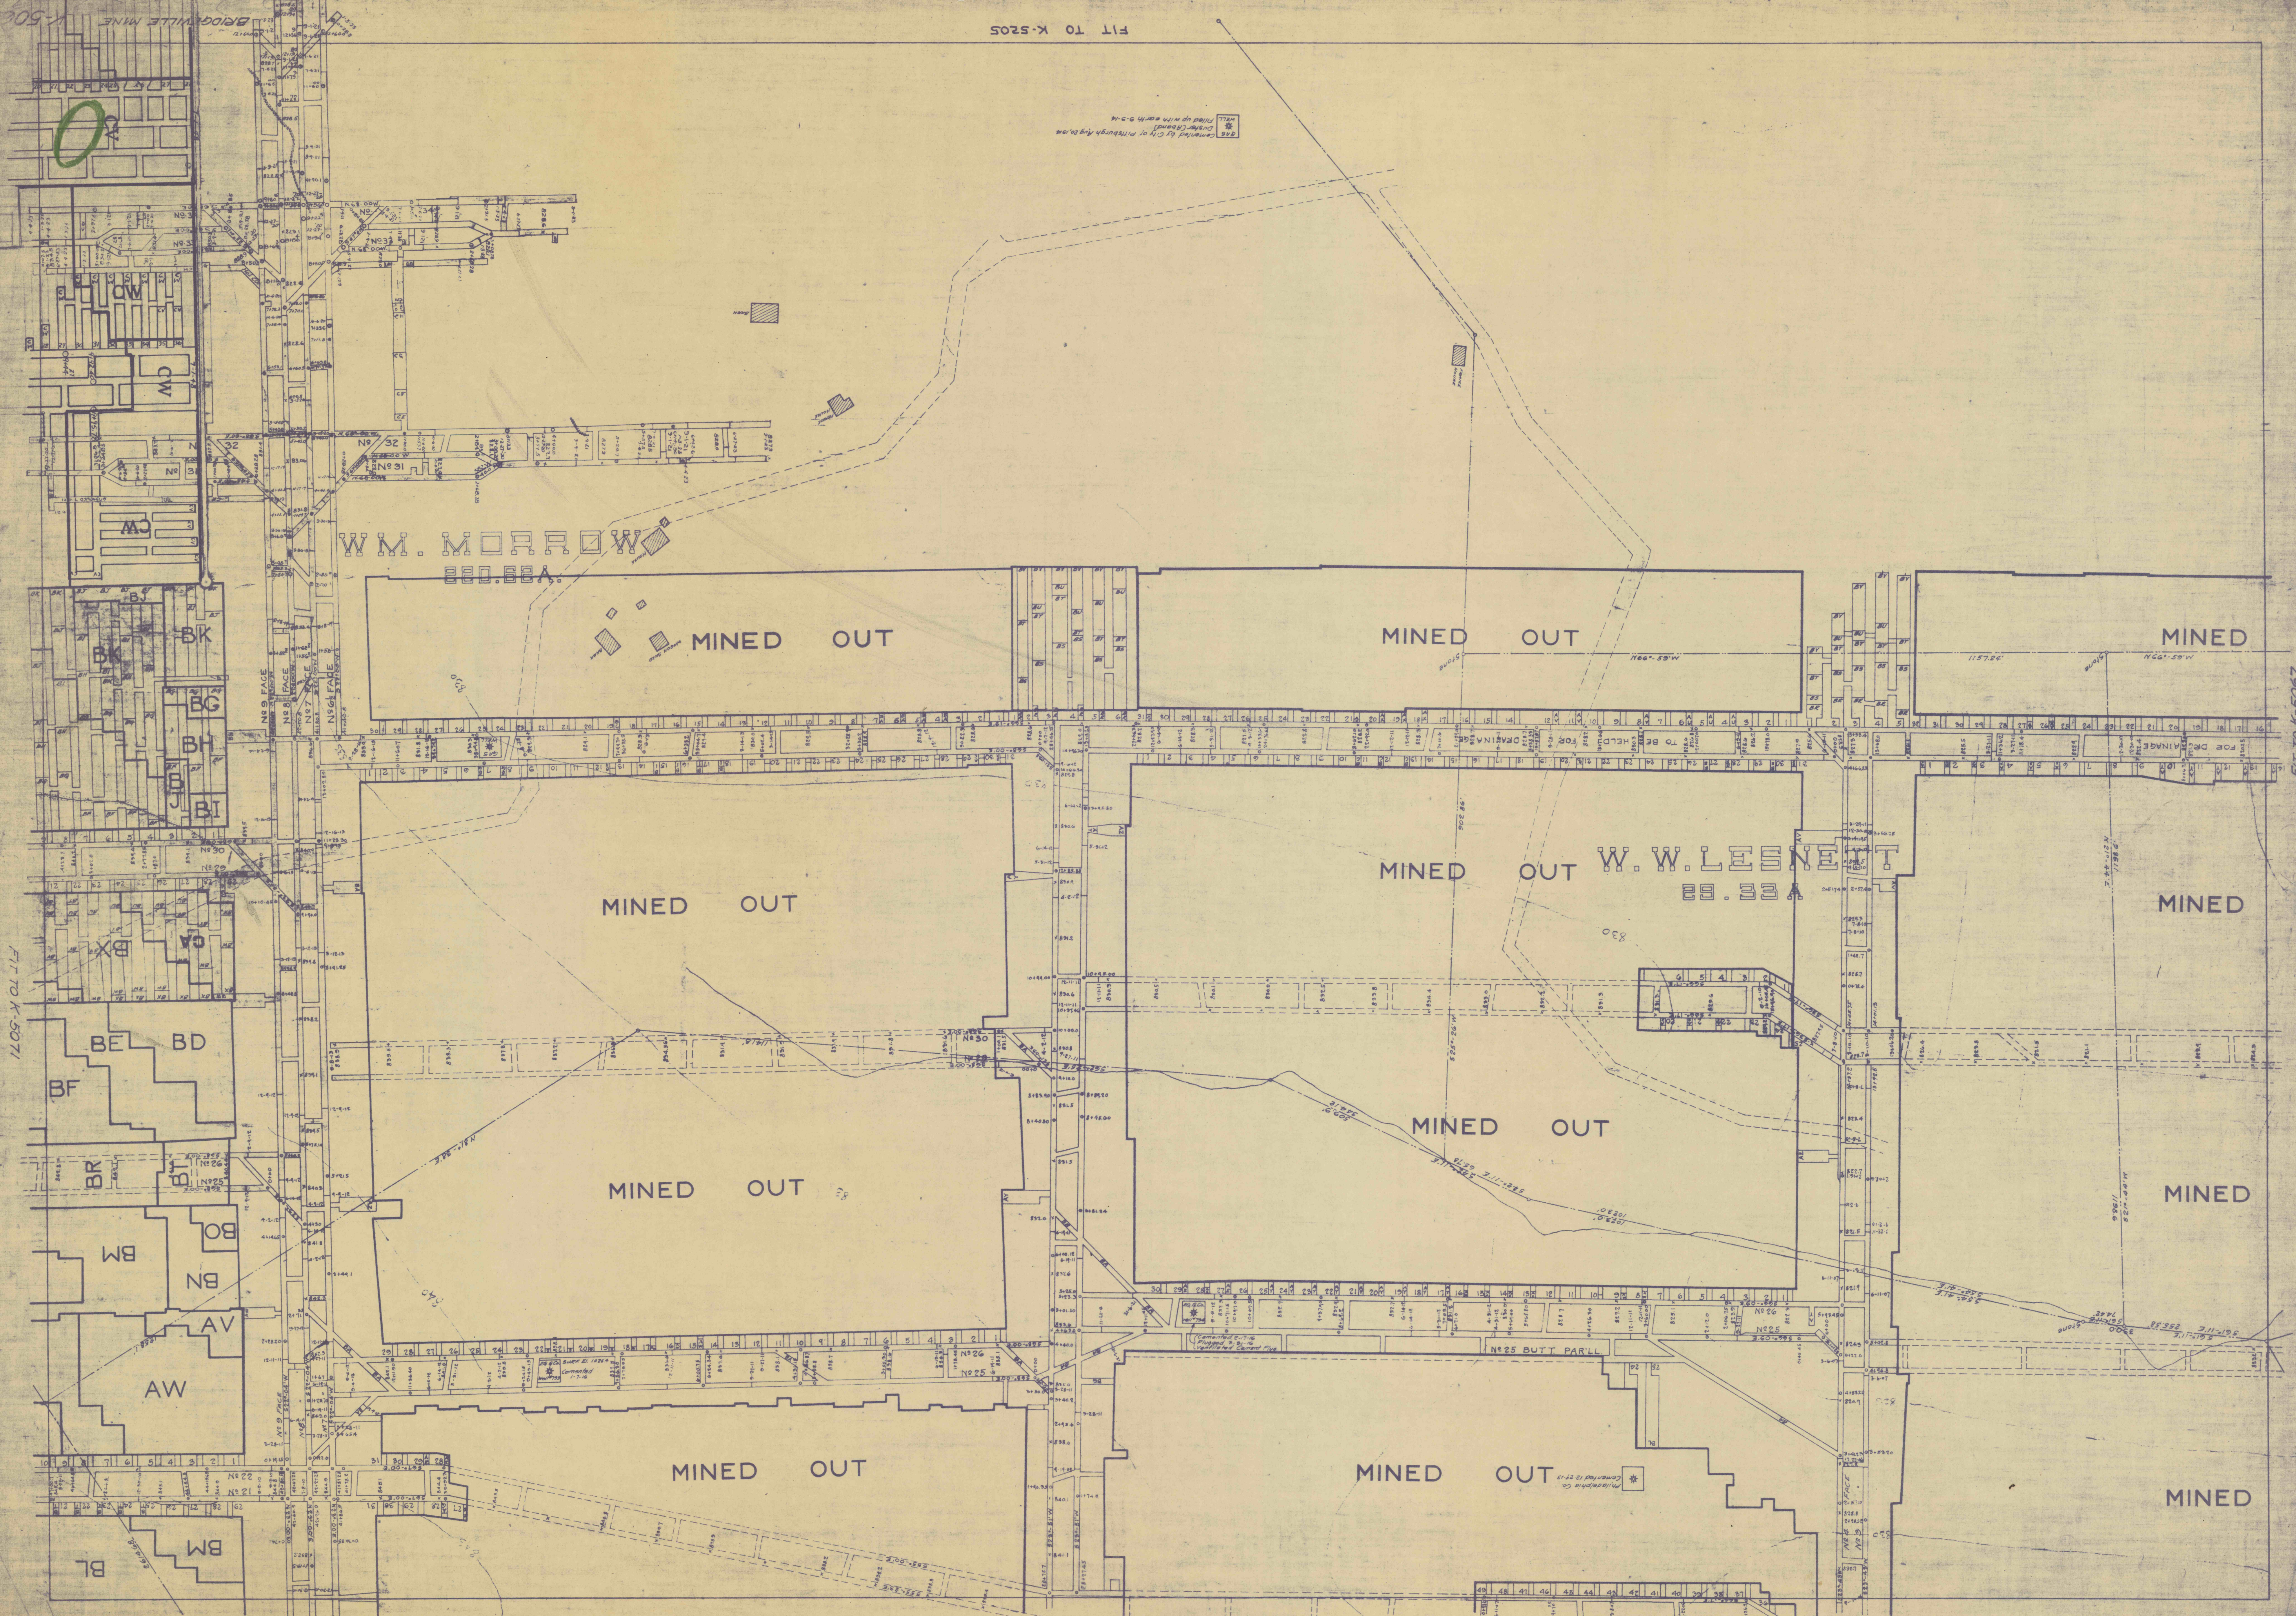

FIT TO K-5068

BRIDGEVILLE MINE K-5069