

T.J.S. MINING, INC.
T.J.S. NO. 4 MINE
FINAL MAP


This is the Final Map of the T.J.S. No. 4 Mine. The CMAP Number is PA 0961302. The mine was active in the Upper Freeport coal seam. Coal was first mined in January, 1998. Mining was completed and final mapping was completed on February 26, 2004. All mining was continuous during that period. T.J.S. Mining, Inc. was the only owner and operator of the T.J.S. No. 4 Mine. The mine surveying was per standard accepted mine surveying methods and procedures. The mine survey system maintained a minimum Linear Error of Closure and associated Precision of 1:5,000. As of this date, July 19, 2004, the mine has been permanently sealed and all available survey data has been presented. The final survey date is February 26, 2004.

The T.J.S. No. 4 Mine is not bonded by any active mines. Any mining adjacent to the T.J.S. No. 4 Mine has been completed.

This map represents the final limits and mine survey of the T.J.S. No. 4 Mine.

I certify that to the best of my knowledge that this final map of the T.J.S. No. 4 Mine is an accurate representation of the limits and workings of the T.J.S. No. 4 Mine and is the true "FINAL MAP".

James J. Szalankiewicz, PLS, PLS
 Vice President
 T.J.S. Mining, Inc.
 July 26, 2004

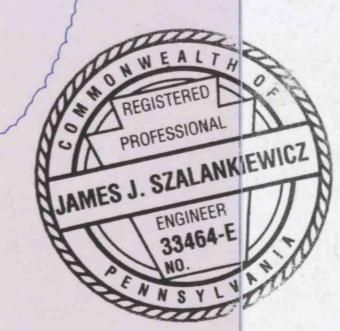

T.J.S. 04 Deep Mine Subsidence
MAP LEGEND

Gas Well / Active	⊙
Gas Well / Abandoned	⊖
Spring	○
Water Well	○
Coal Contour	—
100 Foot Cover Line	—
Six (6) Months Projected Mining	—
Mine Permit	—
Line of Mining Boundary & Subsidence Boundary	—
1000 Foot Adjacent Area	—
Property Line	—
Stream	—
Drill Hole	⊙
Projected Structure	□
Unprojected Structure	□
Support Area	▨
Planned Area	▨

NOTES:
 1. The 2001 UPPER FREEPORT SEAM Surveyed
 Surface and coal owners are the same unless otherwise noted on the map.

Coordinate Grid System
 (SPC) NAD 27
 Unless otherwise noted the subsidence boundary and permit boundary are correct.

7/19/04
 R2