


RECEIVED  
DIVISION OF MINE  
SUBSIDIANCE REGULATION  
FEB 1 1970  
McMURRAY  
PENNSYLVANIA


RECEIVED  
DIVISION OF MINE  
SUBSIDIANCE REGULATION  
FEB 15 1970  
McMURRAY  
PENNSYLVANIA

**PEGGS RUN COAL COMPANY INC.**  
**MINE NO. 2**  
**UPPER FREEPORT COAL SEAM**  
**GREENE TWP. BEAVER COUNTY PA. # 8**  
**SCALE 1" = 200' DATE**

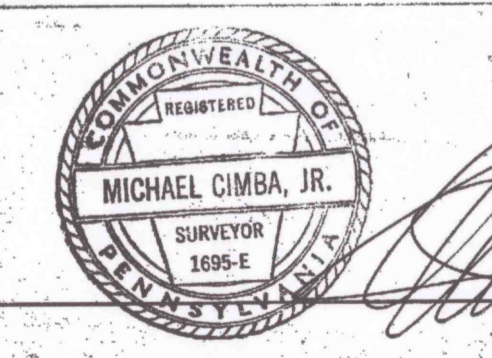

MINE I.D. NO. 38-01057-0

LEGEND

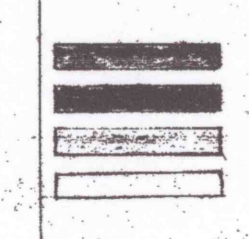

PROPOSED MINING AREA 1-1-78 TO 6-30-78  
NO MINING AREA  
50% MINING AREA  
PRECEDING 6 MONTH COAL MINED AREA  
NO COMPLETED MINING DUE TO POTENTIAL RESERVES IN AREAS BEYOND

1  
FEB 78