


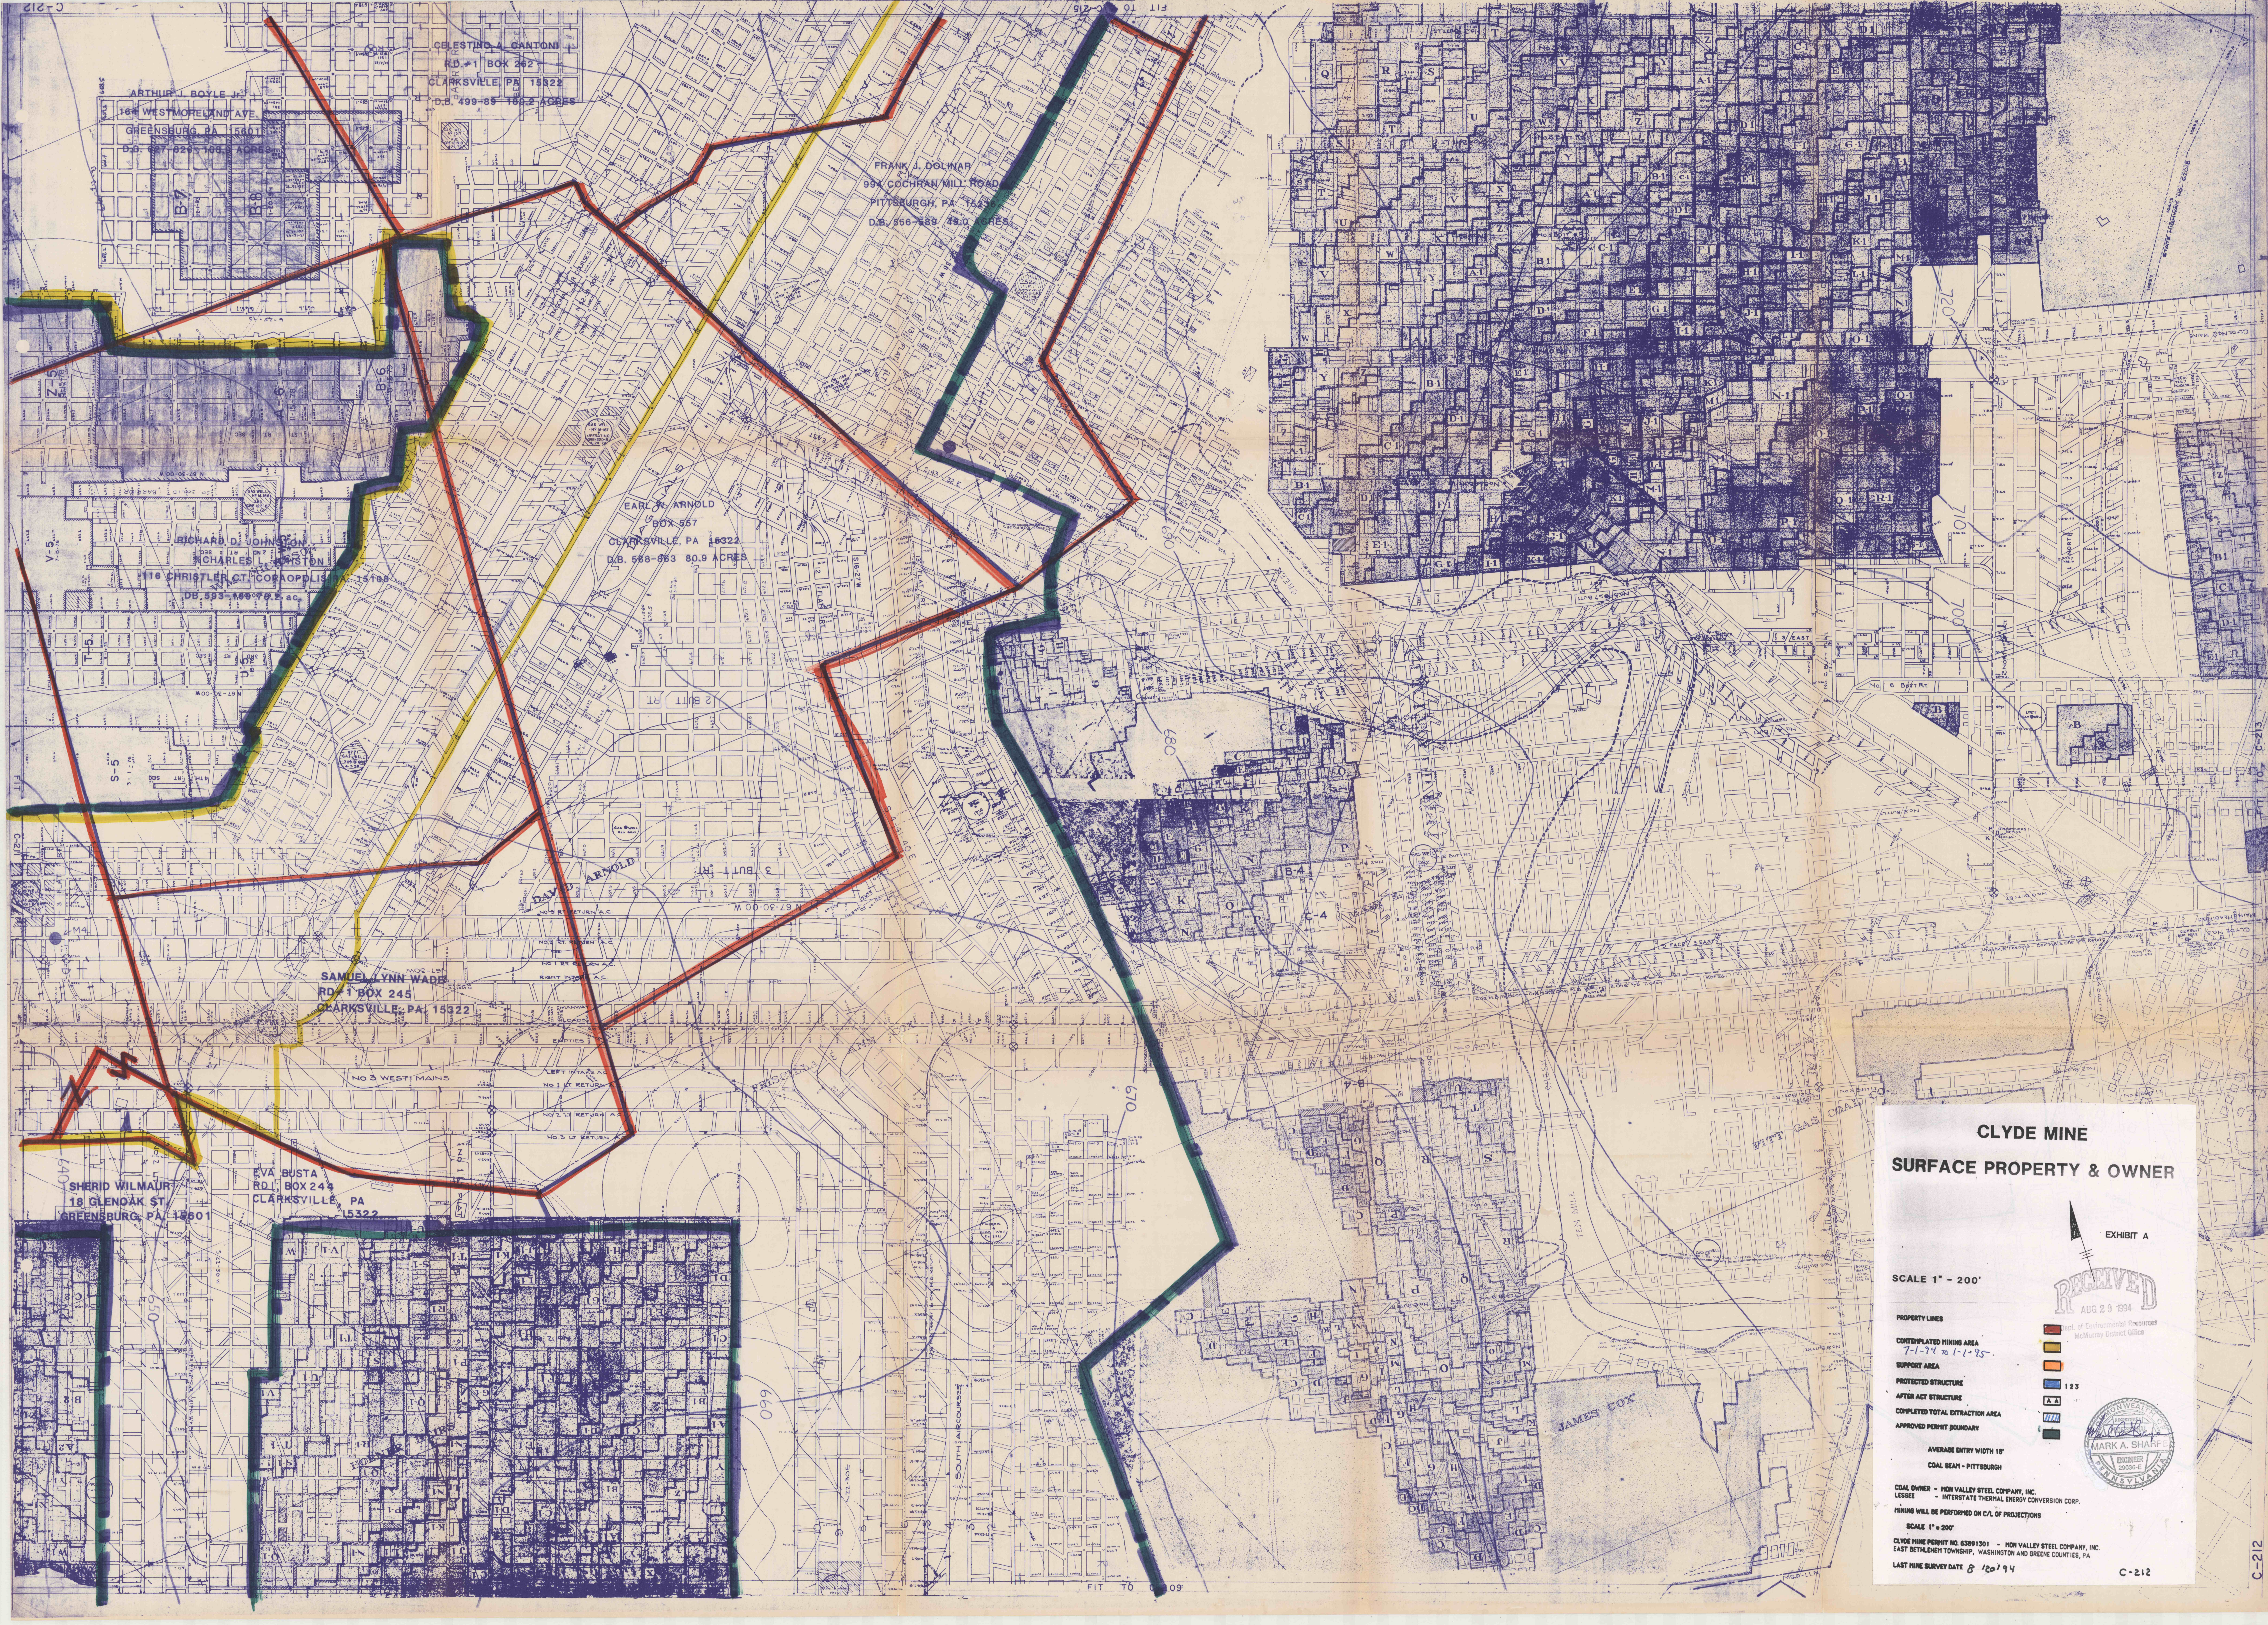

CLYDE MINE
SURFACE PROPERTY & OWNER

EXHIBIT A

SCALE 1" = 200'

PROPERTY LINES

CONTINGENT MINING AREA
7-1-74 to 1-1-75

SUPPORT AREA

PROTECTED STRUCTURE

AFTER ACT STRUCTURE

COMPLETED TOTAL EXTRACTION AREA

APPROVED PERMIT BOUNDARY

AVERAGE ENTRY WIDTH 18'

COAL SEAM - PITTSBURGH

COAL OWNER - HOW VALLEY STEEL COMPANY, INC.
LESSEE - INTERSTATE THERMAL ENERGY CONVERSION CORP.

MINING WILL BE PERFORMED ON C.A. OF PROJECTIONS

SCALE 1" = 200'

CLYDE MINE PERMIT NO. 82691301 - HOW VALLEY STEEL COMPANY, INC.
EAST BETHEL TOWNSHIP, WASHINGTON AND GREENE COUNTIES, PA

LAST MINE SURVEY DATE 8/20/94

RECEIVED
AUG 29 1994
Dept. of Environmental Protection
McMurray District Office

MARK A. SHARP
ENGINEER
20030-R
PENNSYLVANIA

C-212