


LEY COAL COMPANY

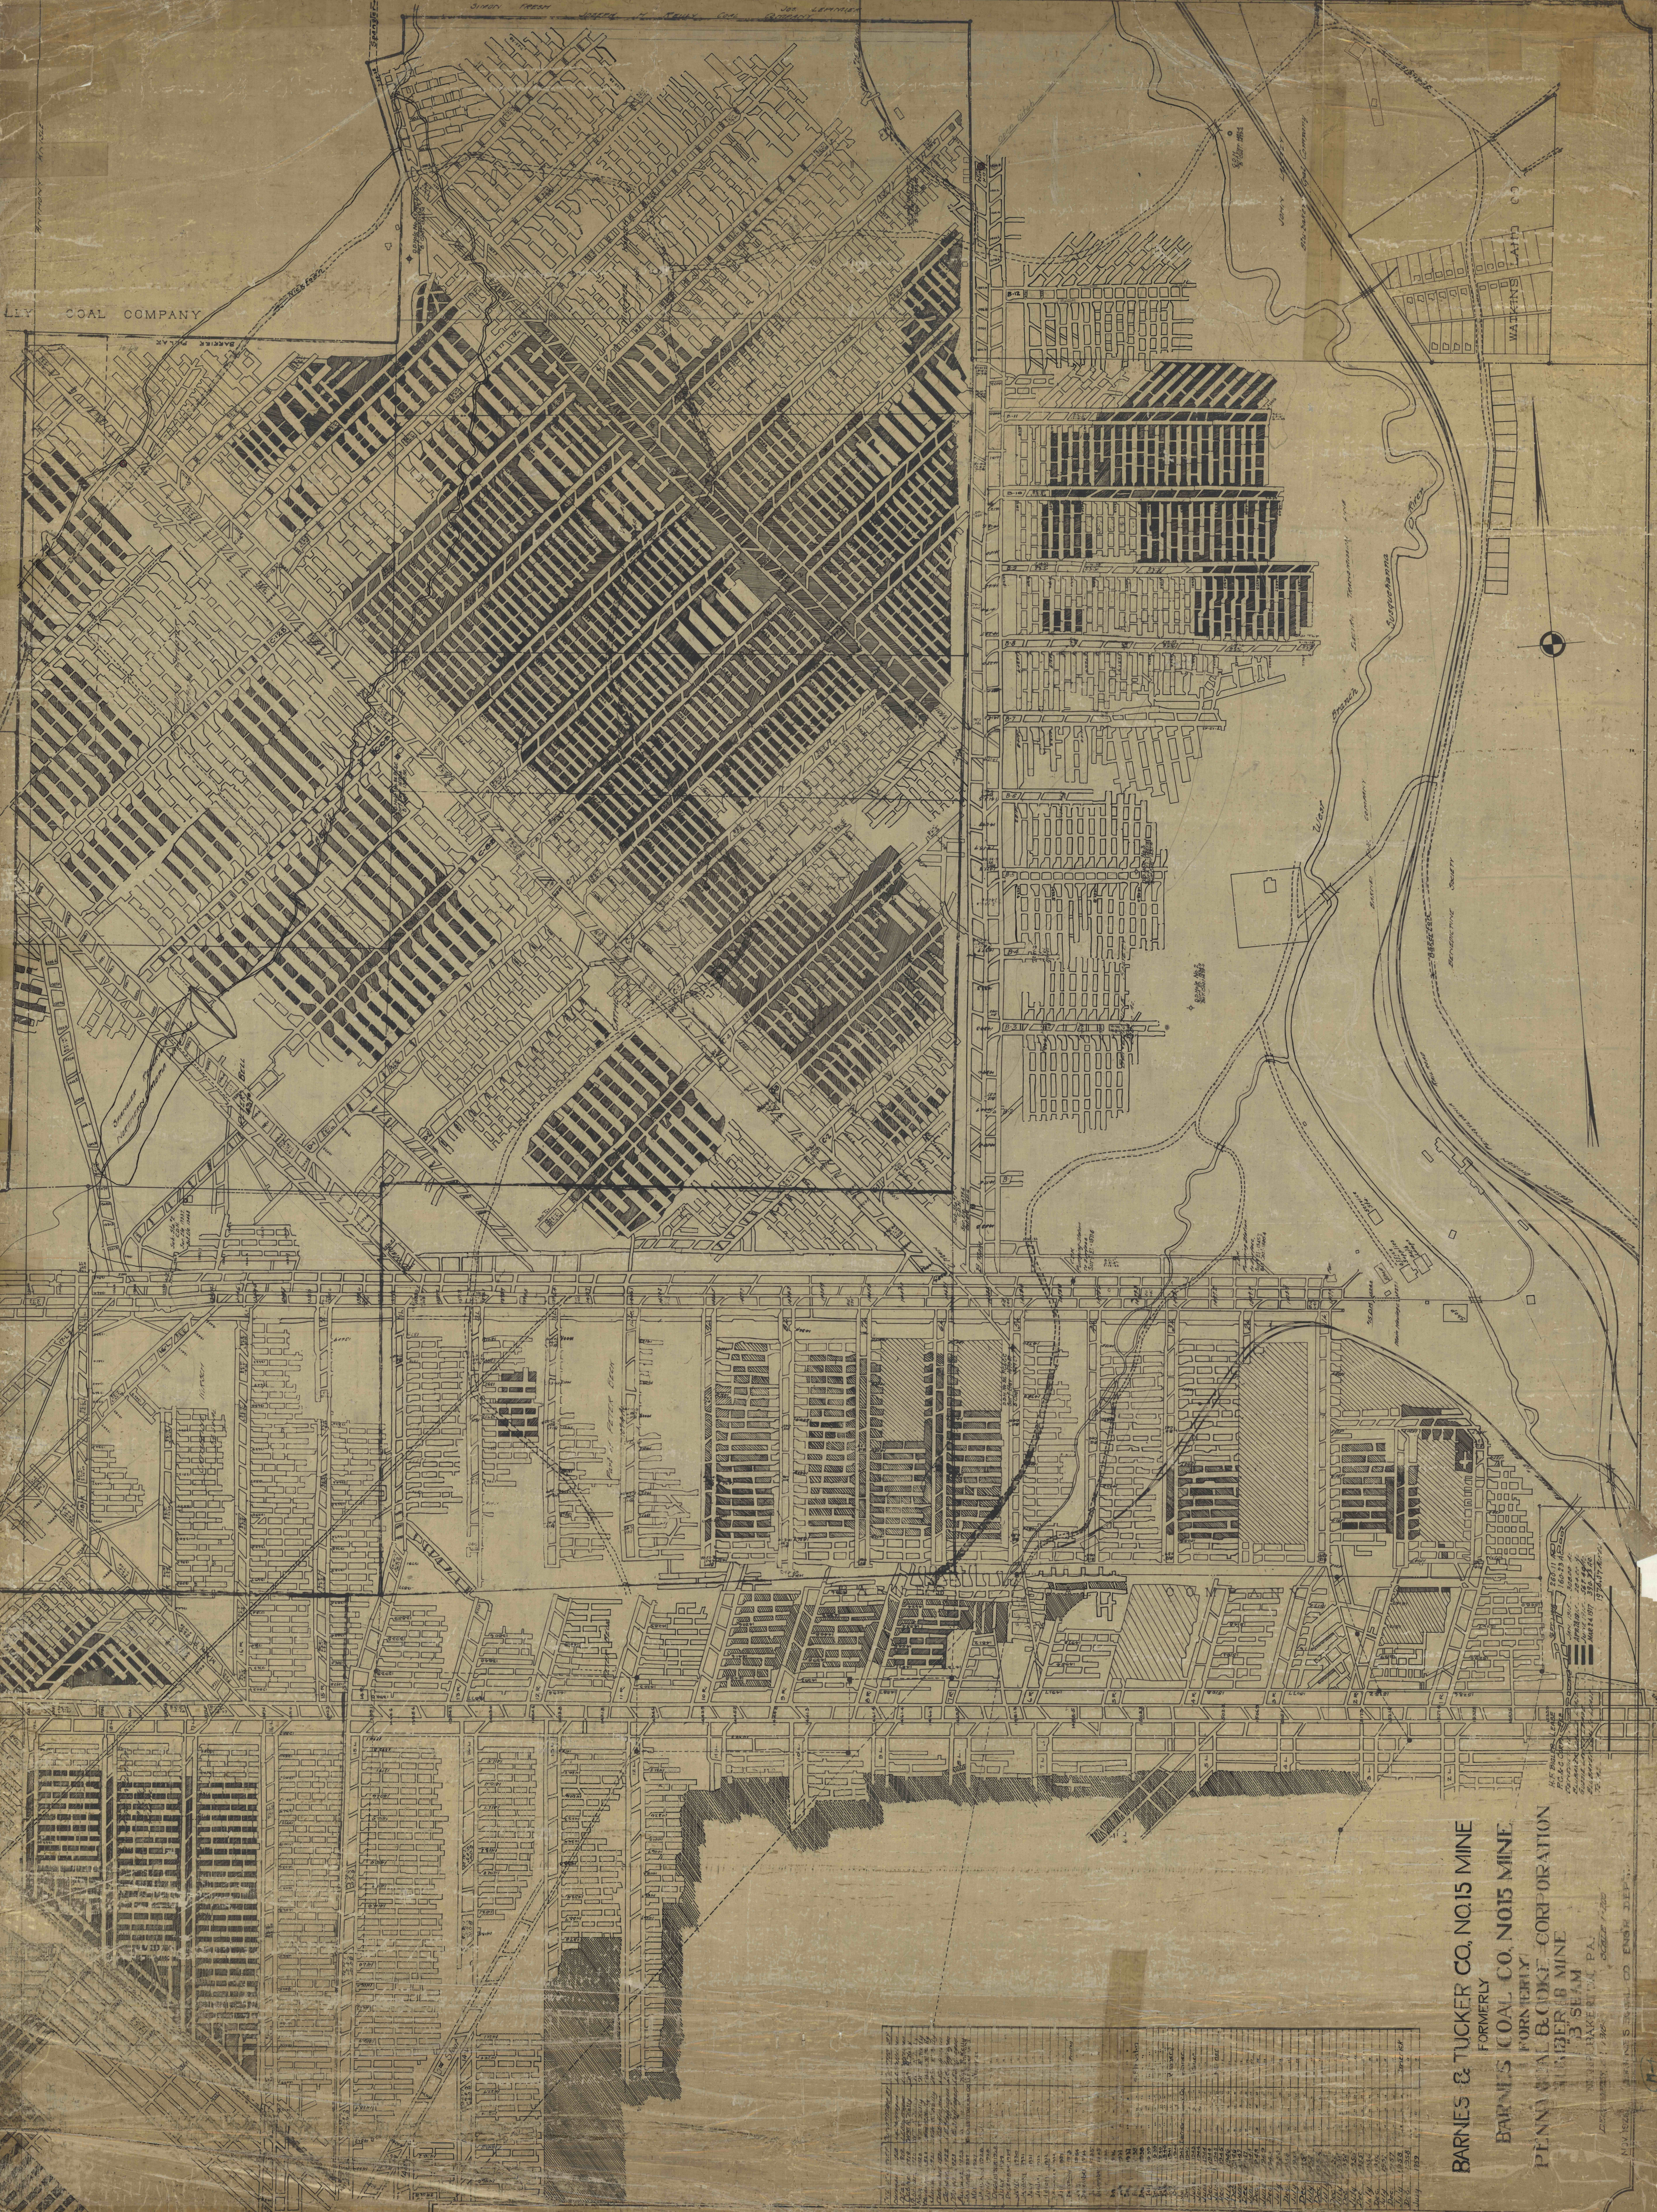

BARNES & TUCKER CO. NO. 15 MINE
 FORMERLY
BARNES COAL CO. NO. 15 MINE
 FORMERLY
PENNA. COAL & COKE CORPORATION
 FORMERLY

