


EXHIBIT 2 Month Projection Map
 RAMPIDE COLLIERY
 MINE
 RICHMOND TOWNSHIP, DARBY COUNTY, PA.
FINAL MAP
 Areas of the mine labeled "M" delineate areas that were surveyed and certified by Musser Engineering, Inc. Those areas are considered "FINAL" for the Rampide No. 1 Mine. Musser Engineering, Inc. does not finalize any area of the mine not surveyed by Musser Engineering, Inc.

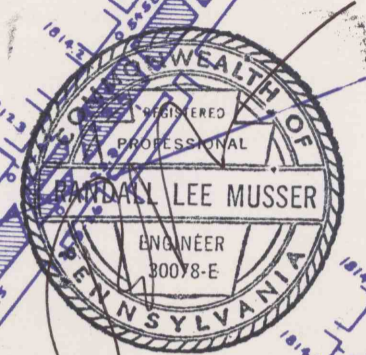

Subsidence Legend
 Permit No. 11861301

Contaminated Mining: [Symbol] From [] To []

Amendment Area: [Symbol]

Mine Plan File:
 Proposed Structure/Structure Height:
 Length of 30' - [Symbol] (1:100)
 Length of 30' - [Symbol] (1:100)
 Width of 30' - [Symbol] (1:100)
 Width of 30' - [Symbol] (1:100)

Previous Six Month's Mining: [Symbol]

Subsidence Permit Line:
 S - Support Area Over Principal Structure
 B - Support Area Over Secondary Structure
 L - Lead of Structure
 W - Width of Structure
 18 FEET - Support Factor
 25% - Factor of Safety

LEGEND

- PROPERTY LINE
- PERMIT LINE
- SUBSIDENCE CONTROL PLAN BO
- POWER LINE
- TOWNSHIP/BOROUGH LINE
- ROADS
- STREAM
- CUTCROSS
- CEMETARY
- BEFORE 1965
- DWELLING
- OTHERS - BARN
- CHURCH
- MINE ENTRIES
- NOT MEASURED

I, Randall L. Musser, a Professional Engineer in the Commonwealth of Pennsylvania, hereby certify that the surveying and mine mapping conducted by Musser Engineering, Inc. after November 22, 1995, was conducted in accordance with generally accepted surveying standards for the mining industry, and is true and correct to the best of my knowledge and belief. All base map preparation for the mine, and all mine surveying and mapping prior to November 22, 1995, was conducted by and certified by the engineering staff of BethEnergy Corporation or Bethwell Corporation and is not the responsibility of Musser Engineering, Inc.



53-A-L-109

53-A-L-103

JIM BLACK JOHN CLARK

53-A-L-111