

NOTE:
 No mining above.
 See previously submitted map for "B" seam mining below.
 Average interburden is Approx. 130'.
 Closed loop survey accuracy is 1:5000.
 Map contains information as required by Part 75.372 and 75.1200.

VENTILATION LEGEND


DATE: _____ SCALE: 1"=200'

- LEGEND**
- INTAKE AIR
 - RETURN AIR
 - INTAKE ESCAPEWAY
 - ALTERNATE ESCAPEWAY WITH DOOR
 - CANVAS CHECK
 - PERMANENT STOPPING
 - TRACK ENTRY
 - BELT
 - REGULATOR
 - OVERCAST
 - PROPOSED SEAL
 - BLEEDER EVALUATION POINT
 - INTAKE EVALUATION POINT
 - MONITORING POINT
 - INTAKE SHAFT
 - RETURN SHAFT
 - PERMANENT STOPPING WITH DOOR
 - SEAL
 - AIRLOCK DOOR

NOTE: NO OIL OR GAS WELLS & NO CH₄ LIBERATED

- LEGEND**
- PROPERTY LINE
 - PERMIT LINE
 - SUBSIDENCE CONTROL PLAN BOUNDARY
 - POWER LINE
 - TOWNSHIP/BOROUGH LINE
 - STREAM
 - OUTCROP
 - BEFORE 1965 DWELLING
 - AFTER 1965 DWELLING
 - OTHERS - BARN
 - CHURCH
 - CEMETARY
 - ROADS
 - MINE ENTRIES NOT MEASURED

FINAL MAP

Areas of the mine labeled "M" delineate areas that were surveyed and certified by Musser Engineering, Inc. Those areas are considered "FINAL" for the Rampside No. 1 Mine. Musser Engineering, Inc. does not finalize any area of the mine not surveyed by Musser Engineering, Inc.

I, Randall L. Musser, a Professional Engineer in the Commonwealth of Pennsylvania, hereby certify that the surveying and mine mapping conducted by Musser Engineering, Inc. after November 22, 1995, was conducted in accordance with generally accepted surveying standards for the mining industry, and is true and correct to the best of my knowledge and belief. All base map preparation for the mine, and all mine surveying and mapping prior to November 22, 1995, was conducted by and certified by the engineering staff of BethEnergy Corporation or Herwind Corporation and is not the responsibility of Musser Engineering, Inc.


- Subsidence Legend**
 Permit No. 11861301
- Contemplated Mining From _____ To _____
- Amendment Area
- Within Plan For Protected Structures/Outcrops
- Previous Six Month's Mining
- Subsidence Permit Line

- 4 Acre area deleted from Subsidence Control Plan Boundary.
- 4 Acre area added to Subsidence Control Boundary.

EXHIBIT 22.6 Six Month Projection Map

RAMPSIDE COLLIERIES, INC
 RAMPSIDE COLLIERIES MINE I

SCALE: 1" = 200'
 DATE: _____
 RICHLAND TOWNSHIP, CAMBERIA COUNTY, PA

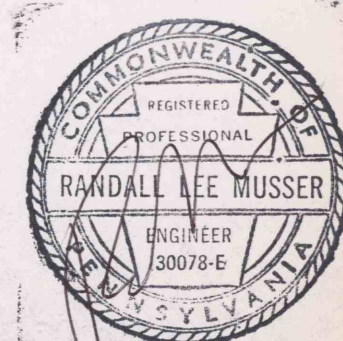

OCT 06 2004