

MAPLE CREEK MINING, INC.  
UMCO ENERGY, INC.

HIGH QUALITY MINE  
PITTSBURGH SEAM


MSHA ID No. 36-08375  
PA-DEP CMAP - 63921301

FINAL MAP

OFFICES:  
981 ROUTE 917  
BENTLEYVILLE, PA 15314

PORTAL:  
1965 ROUTE 481  
MONONGAHELA, PA 15063

CARROLL TOWNSHIP &  
FALLOWFIELD TOWNSHIP  
WASHINGTON COUNTY  
COMMONWEALTH OF PENNSYLVANIA

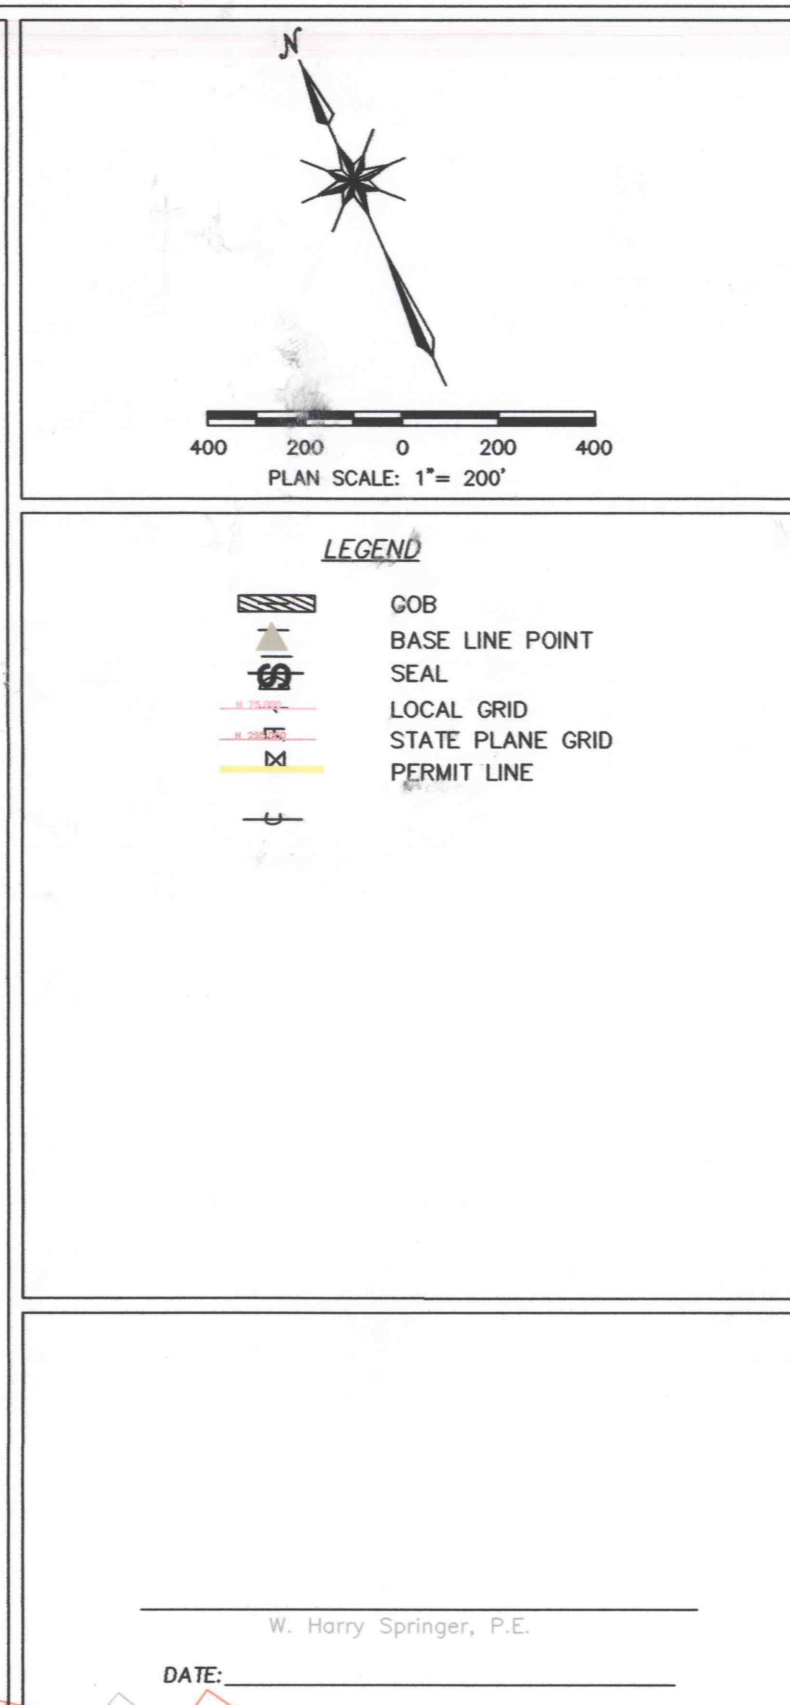

FIT TO PLAN	
A	B
C	D
E	F
G	H
I	J

LEGEND

NOTES:


Date of last mining: February 24, 2005  
No underground mining above or below High Quality Mine.  
Closed loop survey (1 in. = 5,000 feet)  
Base Monument Point No. 1  
Elev: 101,929.12 ±, 3,245,511 ±, Elev: 1,181.45 MSL  
State Plane: N 308,674.18 E 1,380,639.02 (NAD83)  
Base Monument Point No. 2  
Elev: 91,362.9 ±, 2,274,513 ±, Elev: 1,168.82 MSL  
State Plane: W 308,195.84 E 1,383,153.79 (NAD83)

CORPORATE OFFICERS SIGNATURE



Michael S. Gortner  
Geologist  
UMCO Energy, Inc.

DATE: \_\_\_\_\_

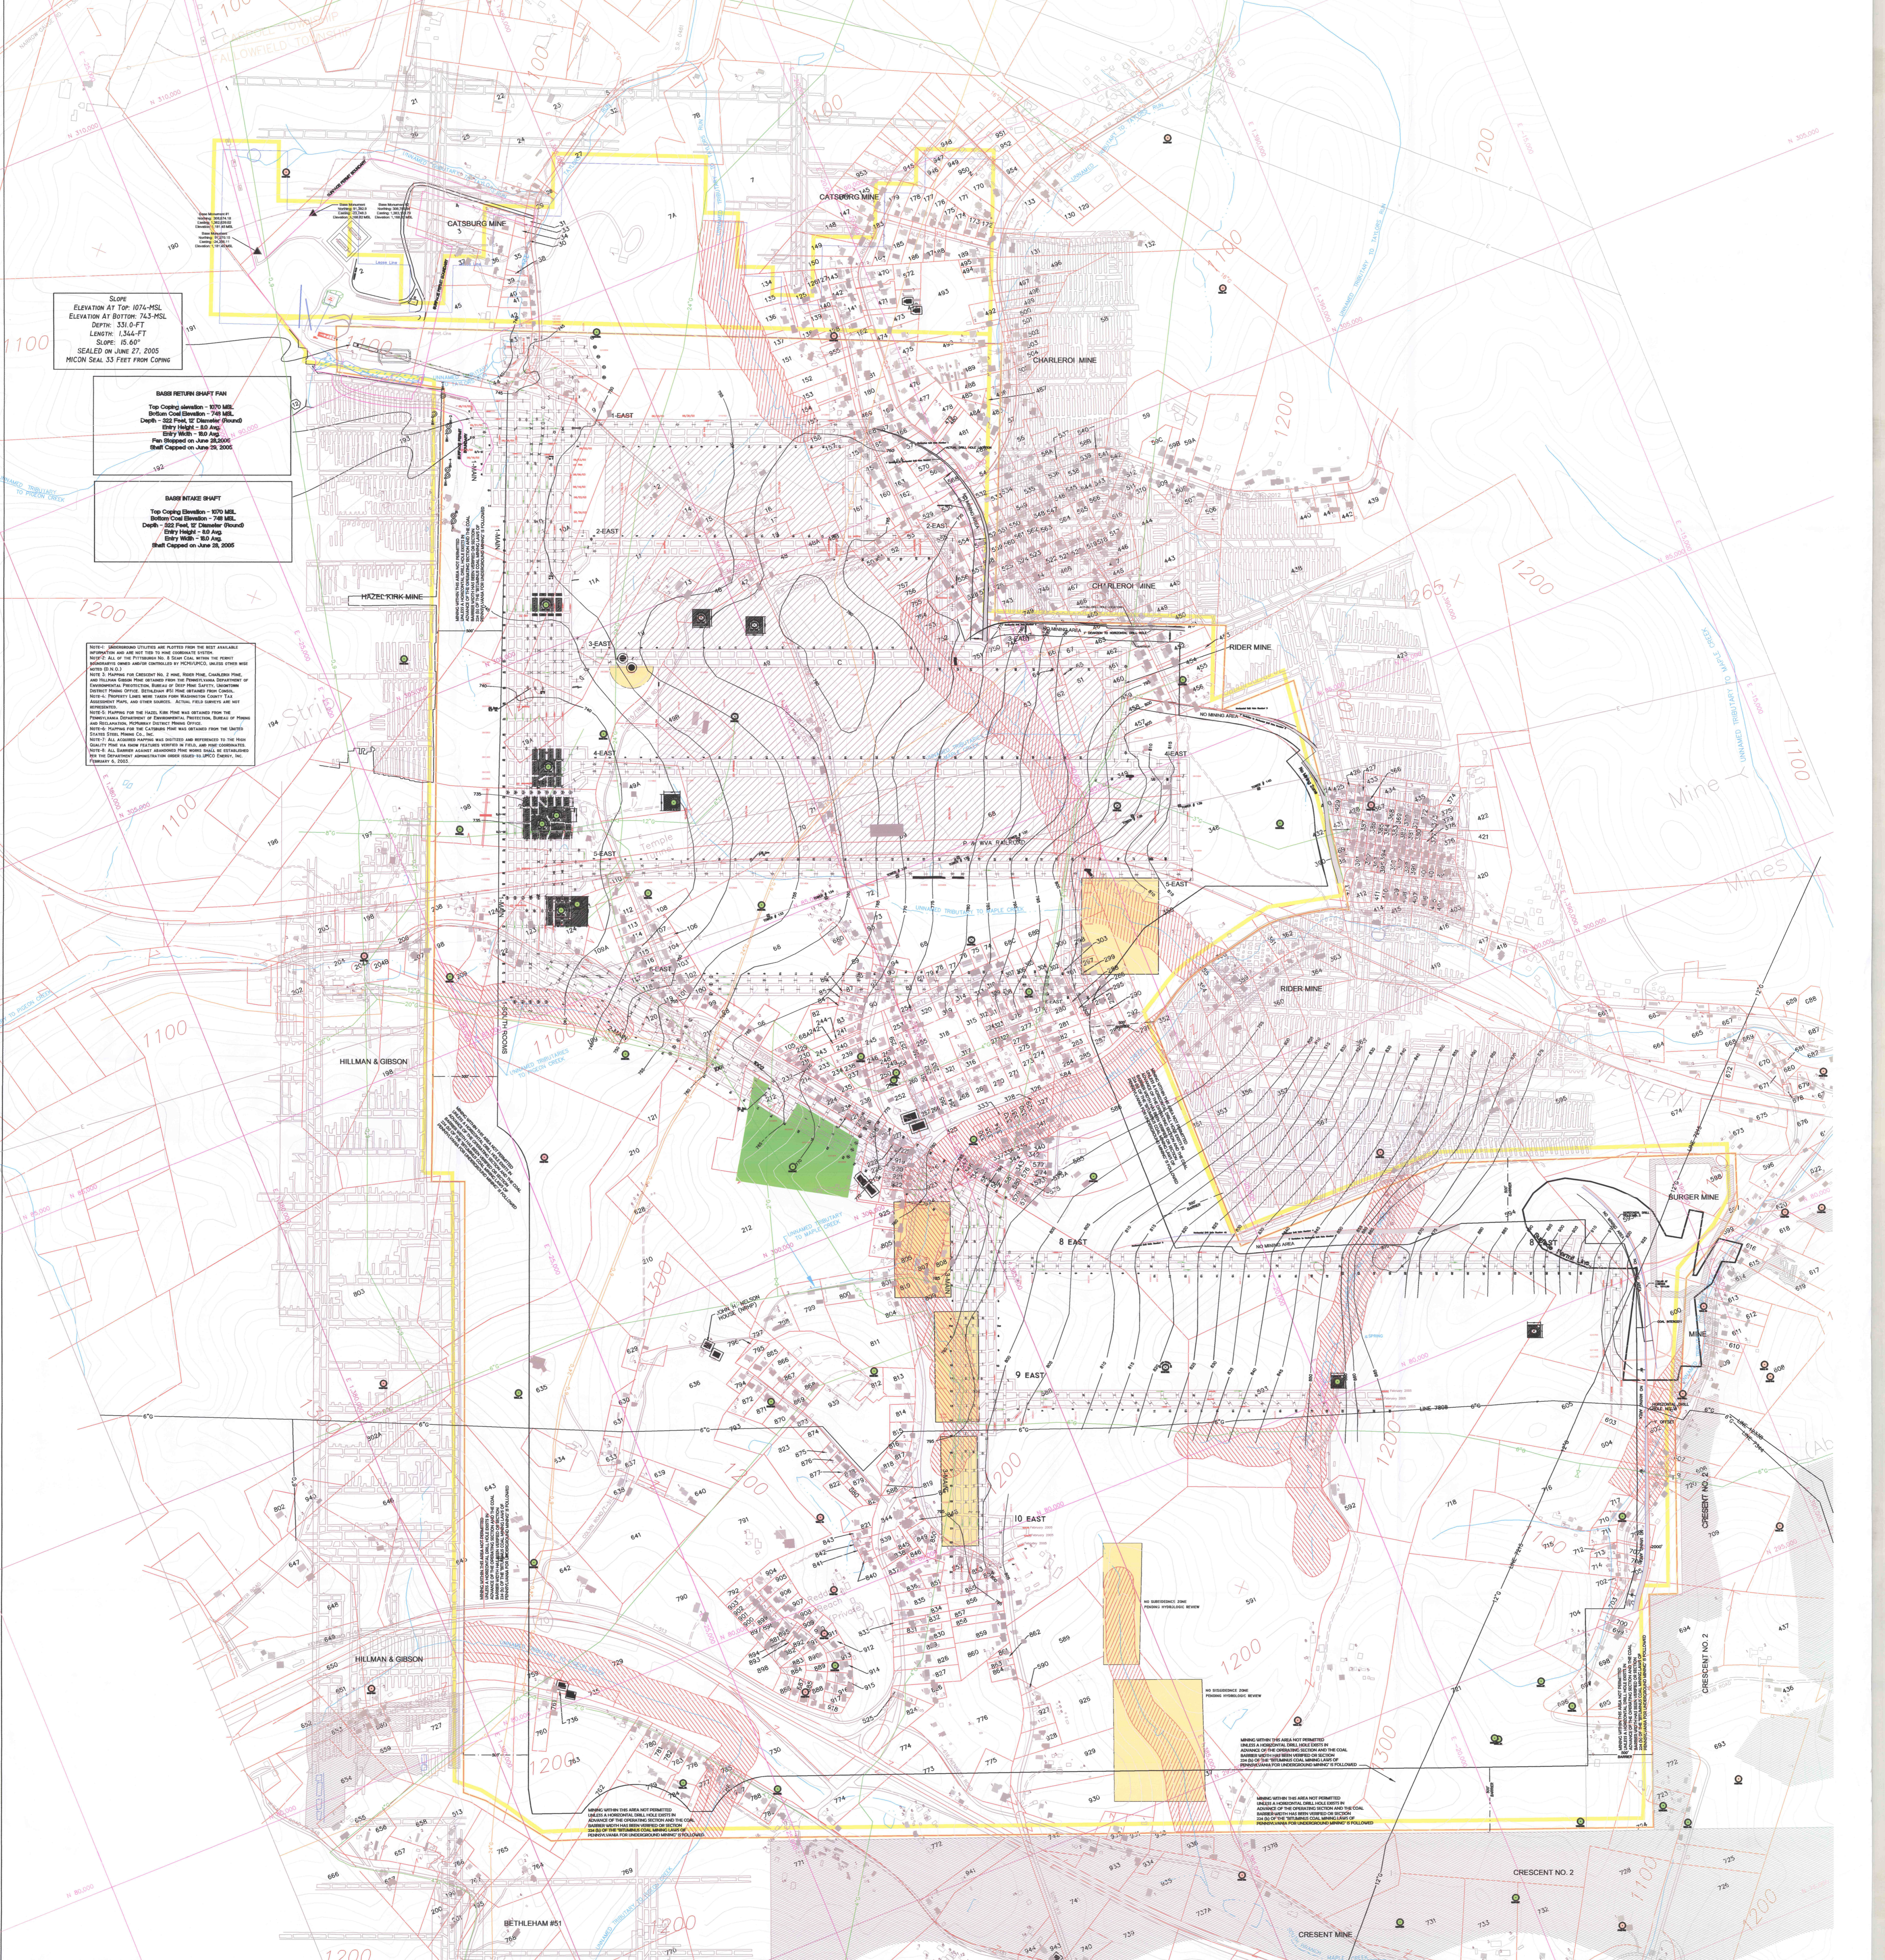

SLOPE  
ELEVATION AT TOP: 1074-MSL  
ELEVATION AT BOTTOM: 743-MSL  
SLOPE: 3.51:1 FT  
LENGTH: 1,344-FT  
SLOPE: 15:1 FT  
SEALED ON JUNE 27, 2005  
MCON SEAL 33 FEET FROM CORNER

BASS RETURN SHAFT PLAN  
Top Coping Elevation - 870 MSL  
Bottom Coping Elevation - 740 MSL  
Depth - 130 Feet 12 Diameter (Round)  
Entry Width - 8'0" Ang  
Fan Located on Mine Surface  
Shaft Capped on June 29, 2005

BASS INTAKE SHAFT  
Top Coping Elevation - 870 MSL  
Bottom Coping Elevation - 740 MSL  
Depth - 130 Feet 12 Diameter (Round)  
Entry Width - 8'0" Ang  
Fan Located on Mine Surface  
Shaft Capped on June 29, 2005

