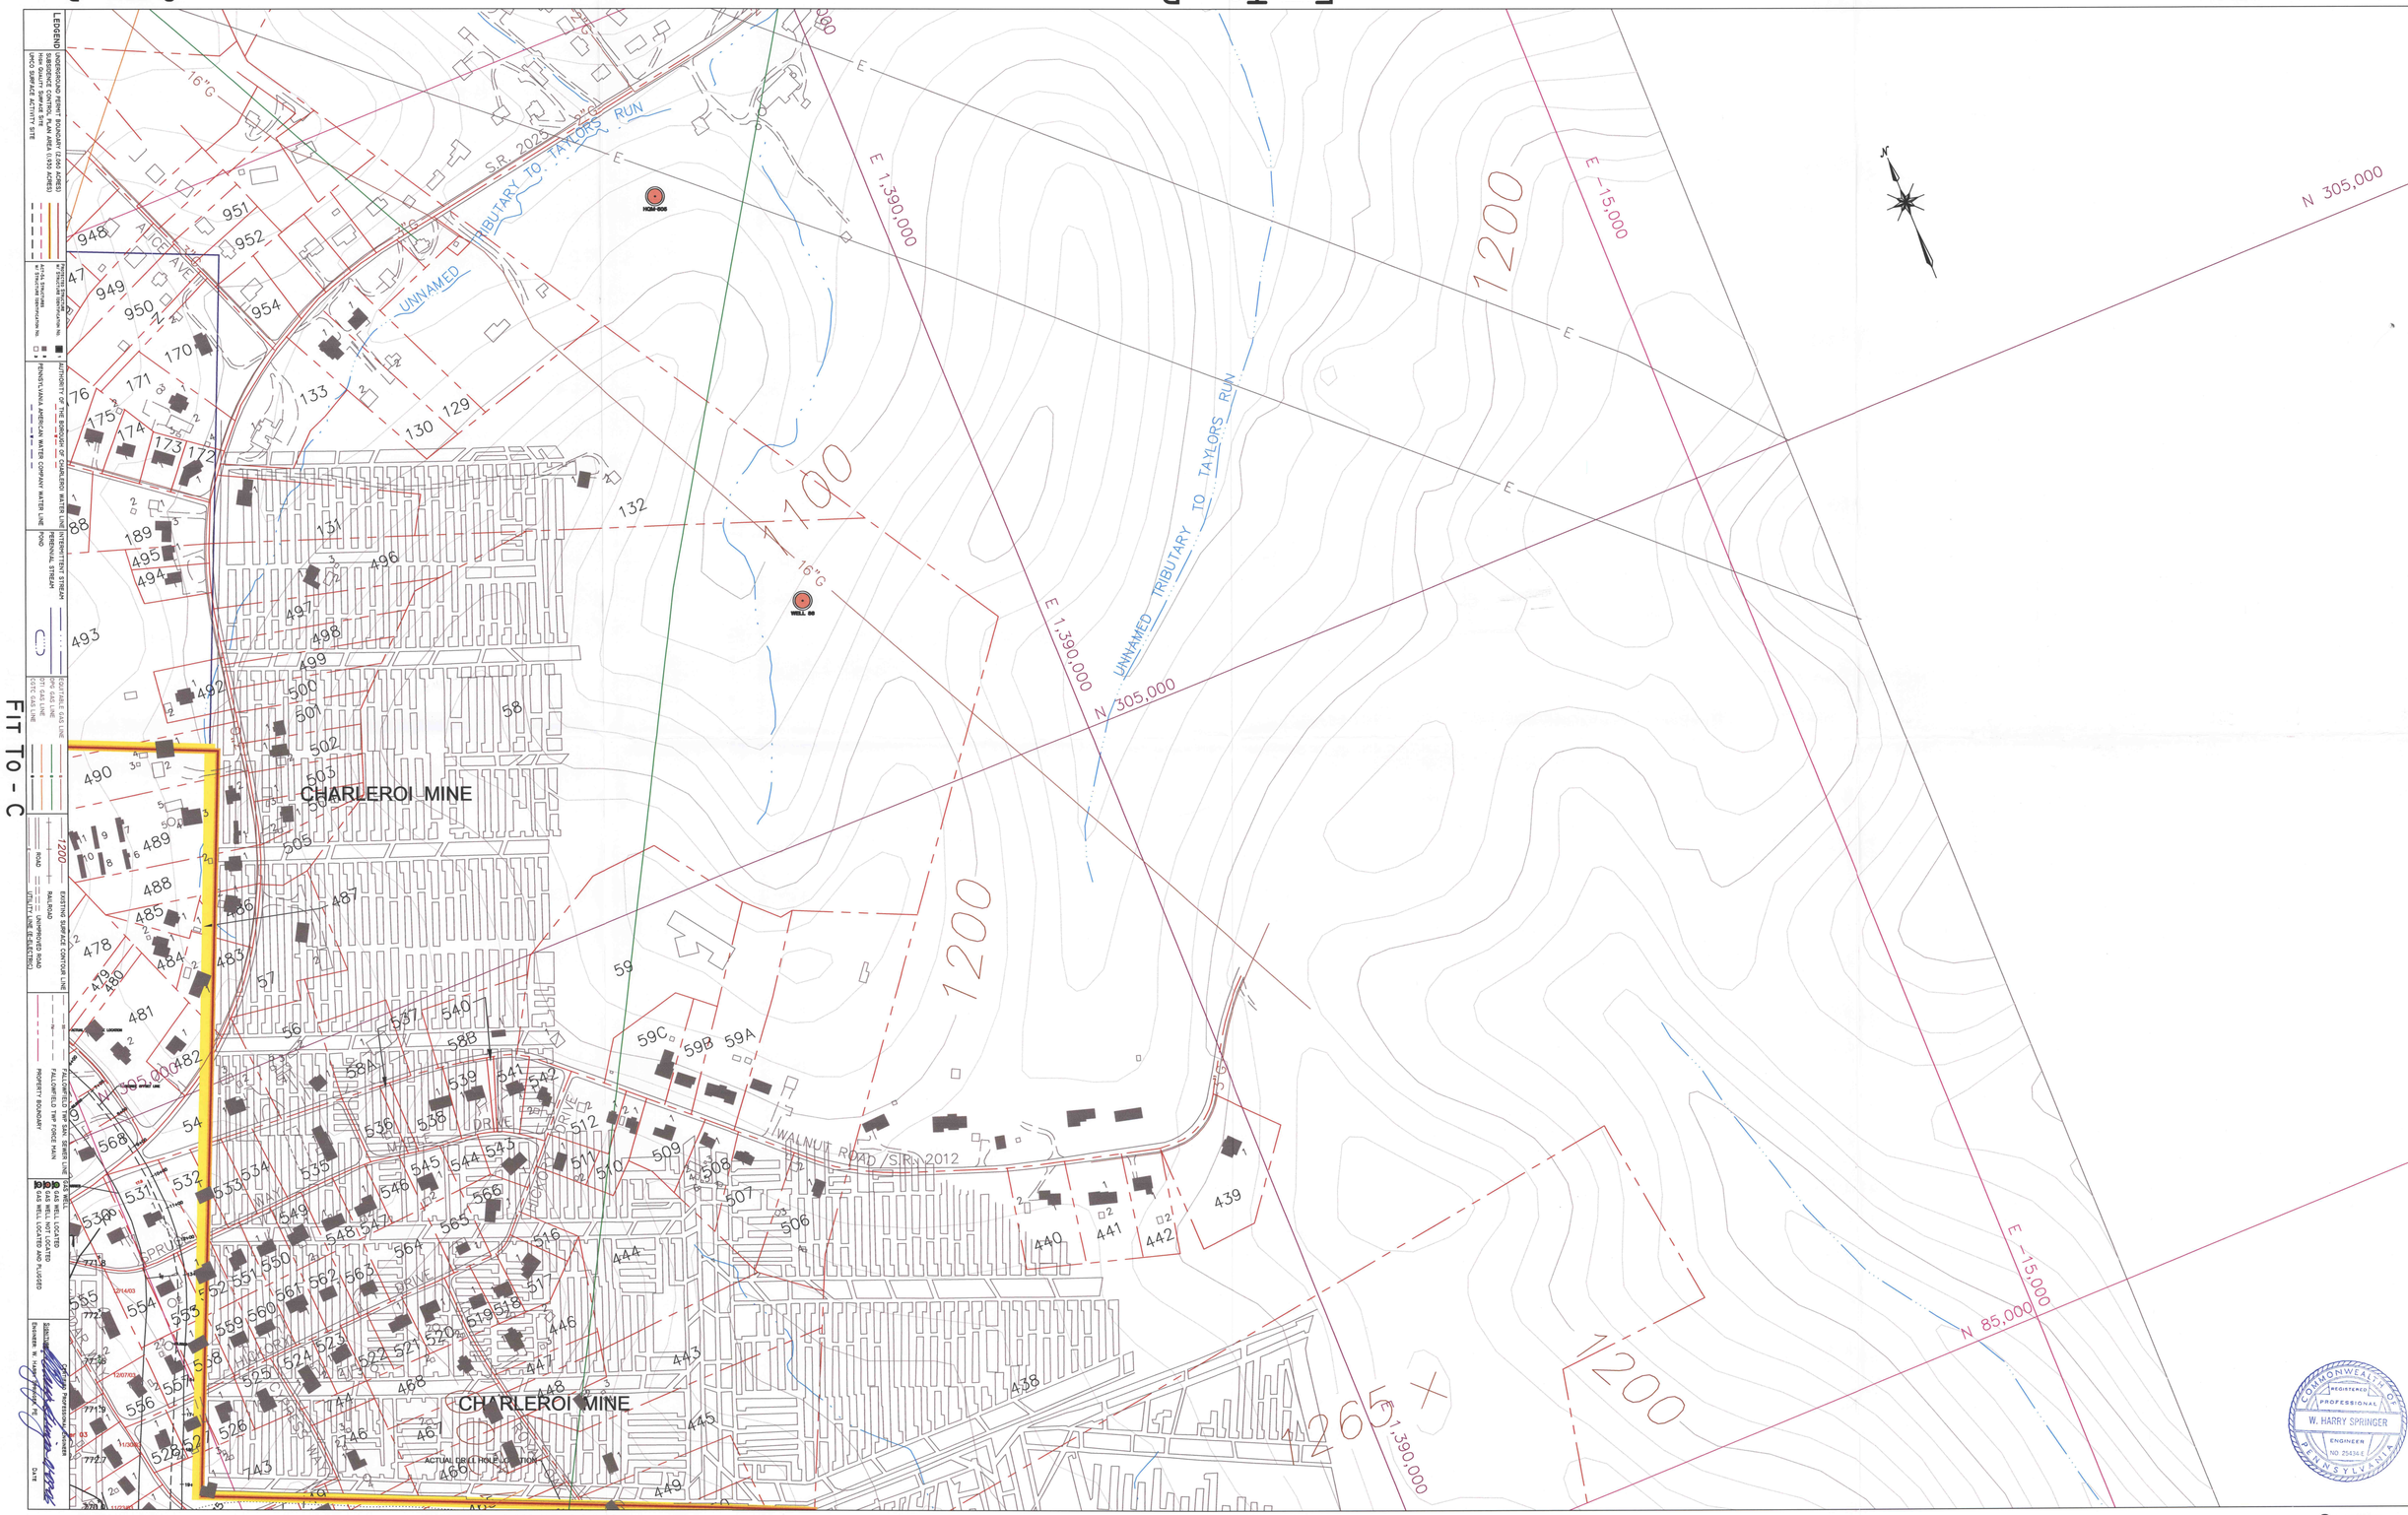

MAPLE CREEK MINING, INC. -- UMCO ENERGY, INC.
HIGH QUALITY MINE

FINAL MINE MAP

MAPLE CREEK MINING, INC. -- UMCO ENERGY, INC.
HIGH QUALITY MINE

FIT TO - F

SHEET - D