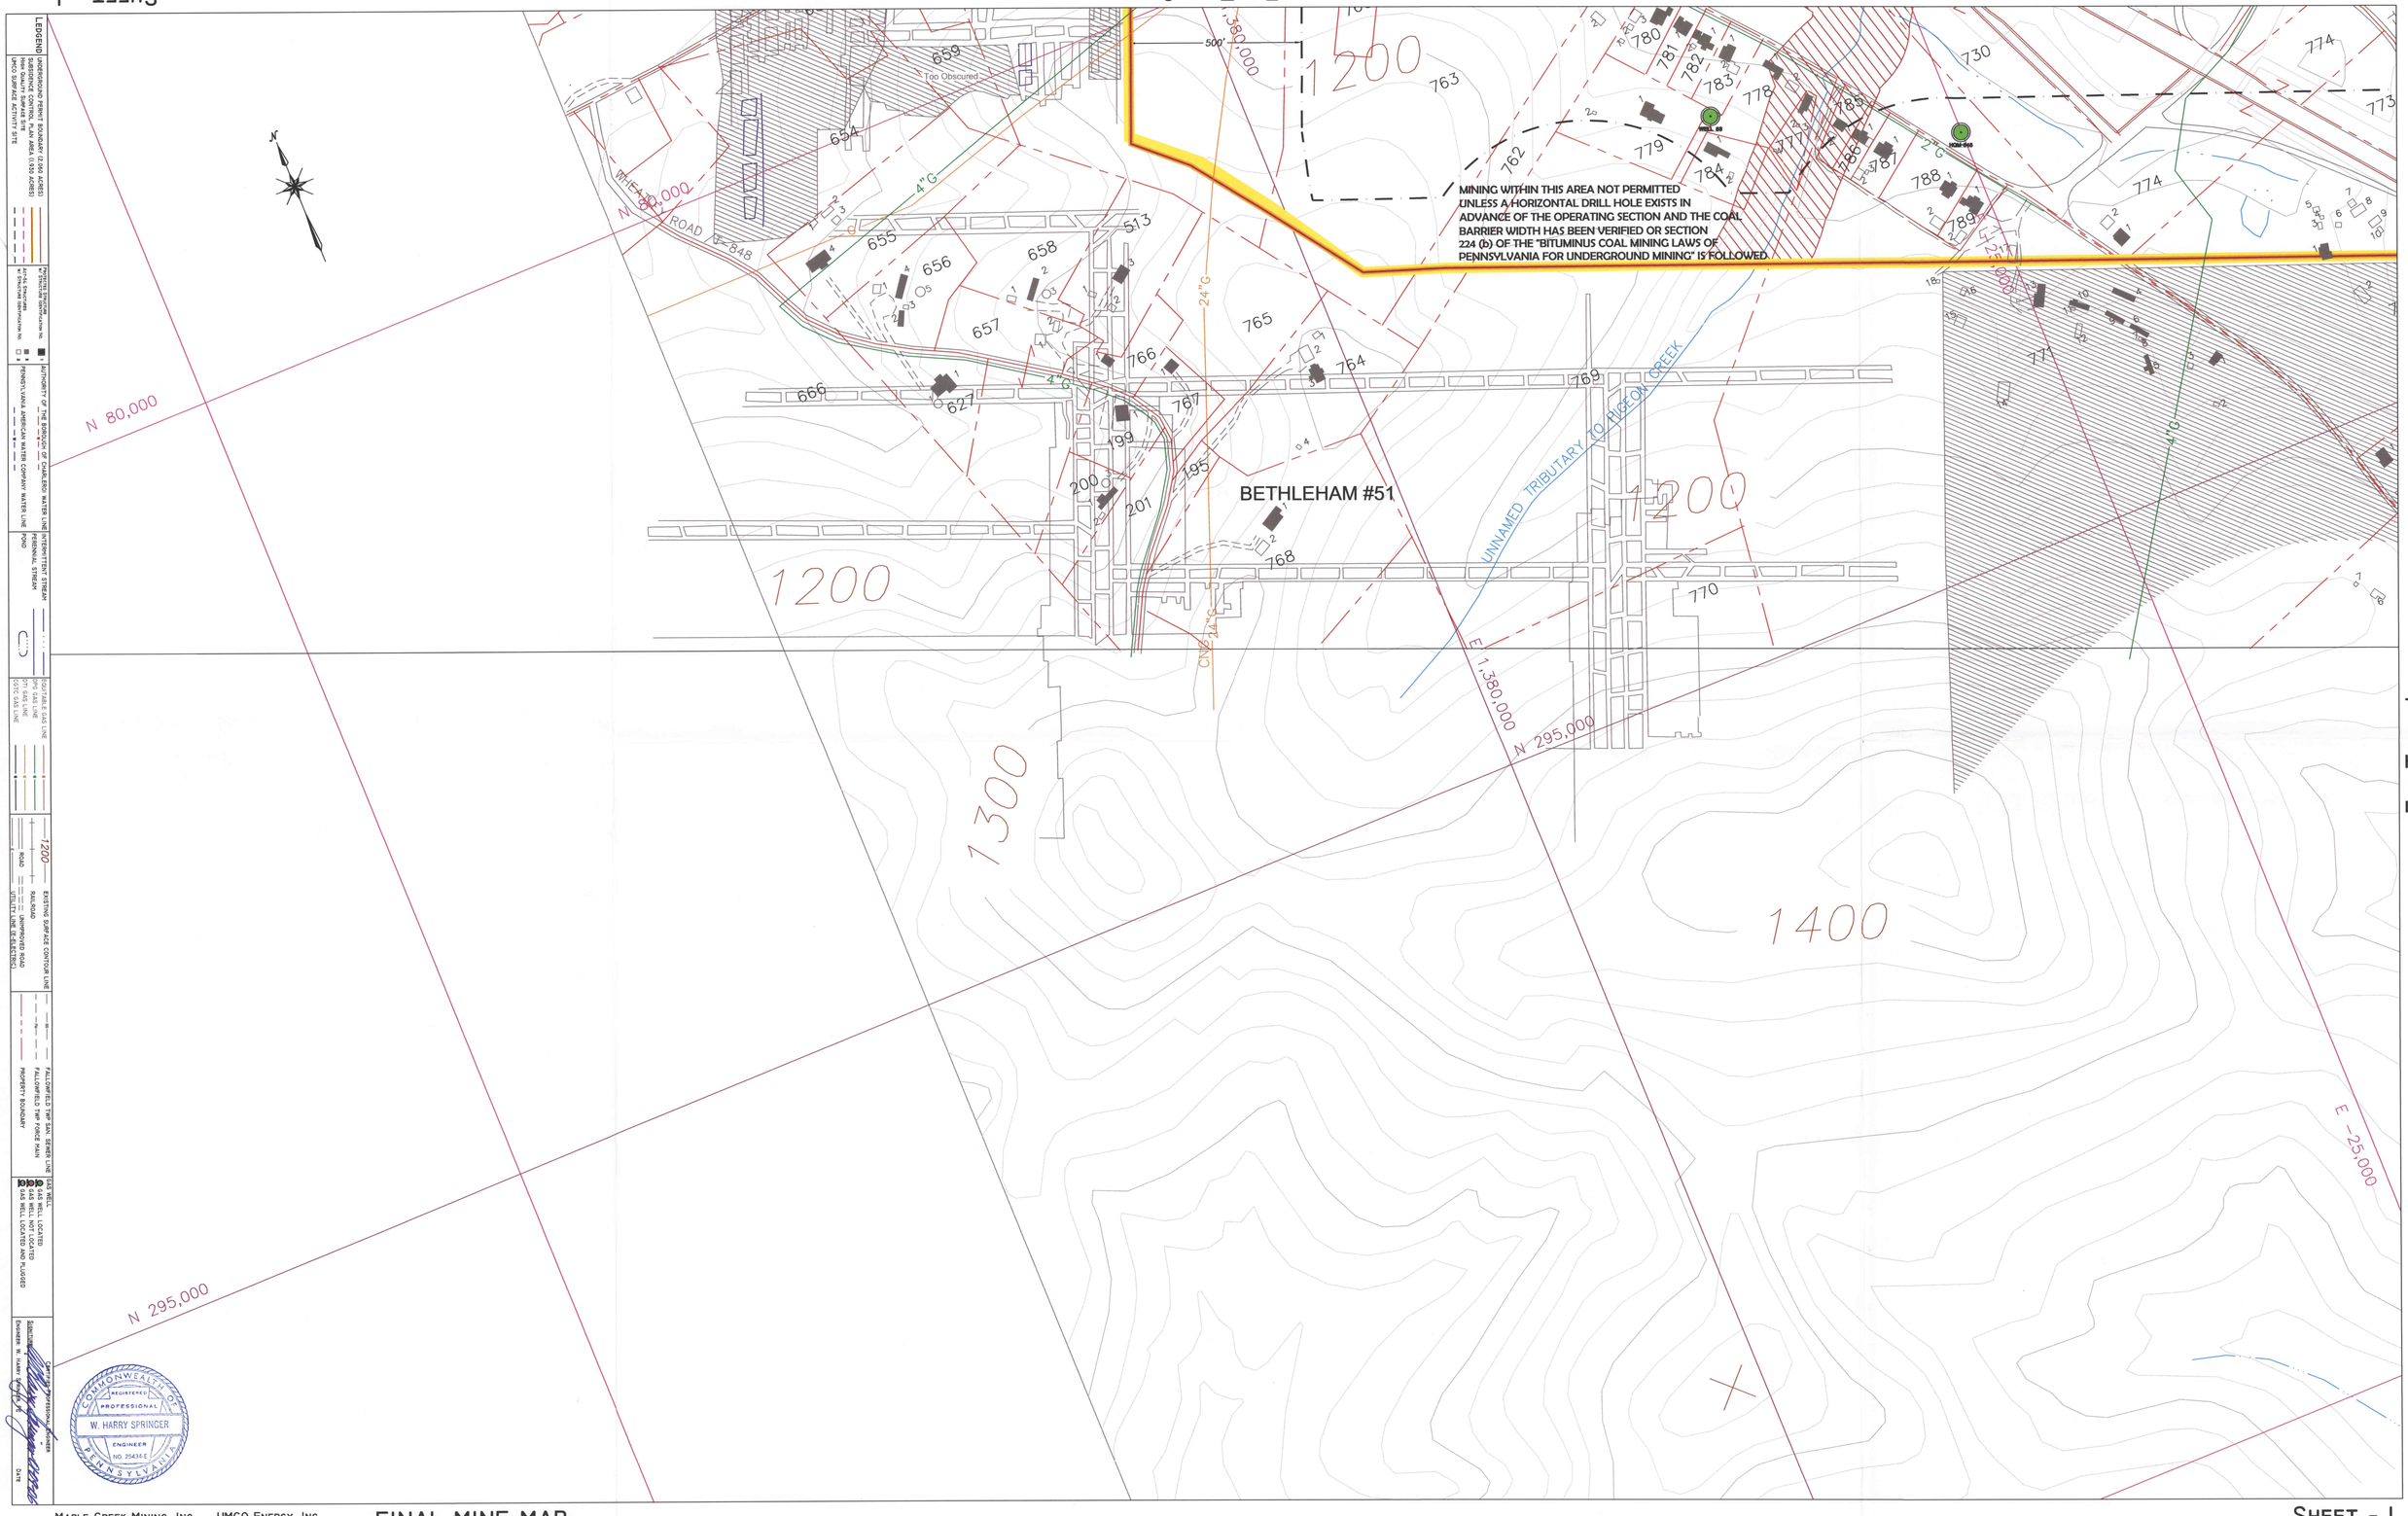

LEGEND

- UNDERGROUND PERMIT BOUNDARY (2,000 ACRES)
- SUBSIDENCE CONTROL PLAN AREA (1,932 ACRES)
- UMCO SURFACE ACTIVITY SITE
- PROPOSED BOREHOLE
- EXISTING BOREHOLE
- ACTUAL STRUCTURES
- PROPOSED STRUCTURES
- AUTHORITY OF THE BOROUGH OF CHARLERO WATER LINE
- PENNSYLVANIA AMERICAN WATER COMPANY WATER LINE
- POND
- INTERMITTENT STREAM
- PERENNIAL STREAM
- SUBTABLE GAS LINE
- ACTIVE GAS LINE
- ABANDONED GAS LINE
- EXISTING SURFACE CONTOUR LINE
- ROAD
- RAILROAD
- UNIMPROVED ROAD
- UTILITY LINE (ELECTRIC)
- FALLOWFIELD TWP SAN. SEWER LINE
- FALLOWFIELD TWP STORM MAIN
- PROPERTY BOUNDARY
- GAS WELL LOCATED
- GAS WELL NOT LOCATED
- GAS WELL LOCATED AND PLUGGED

Surveyor

Engineer W. HARRY SPRINGER

Date

COMMONWEALTH OF PENNSYLVANIA
REGISTERED PROFESSIONAL ENGINEER
W. HARRY SPRINGER
NO. 25434-E

FINAL MINE MAP