
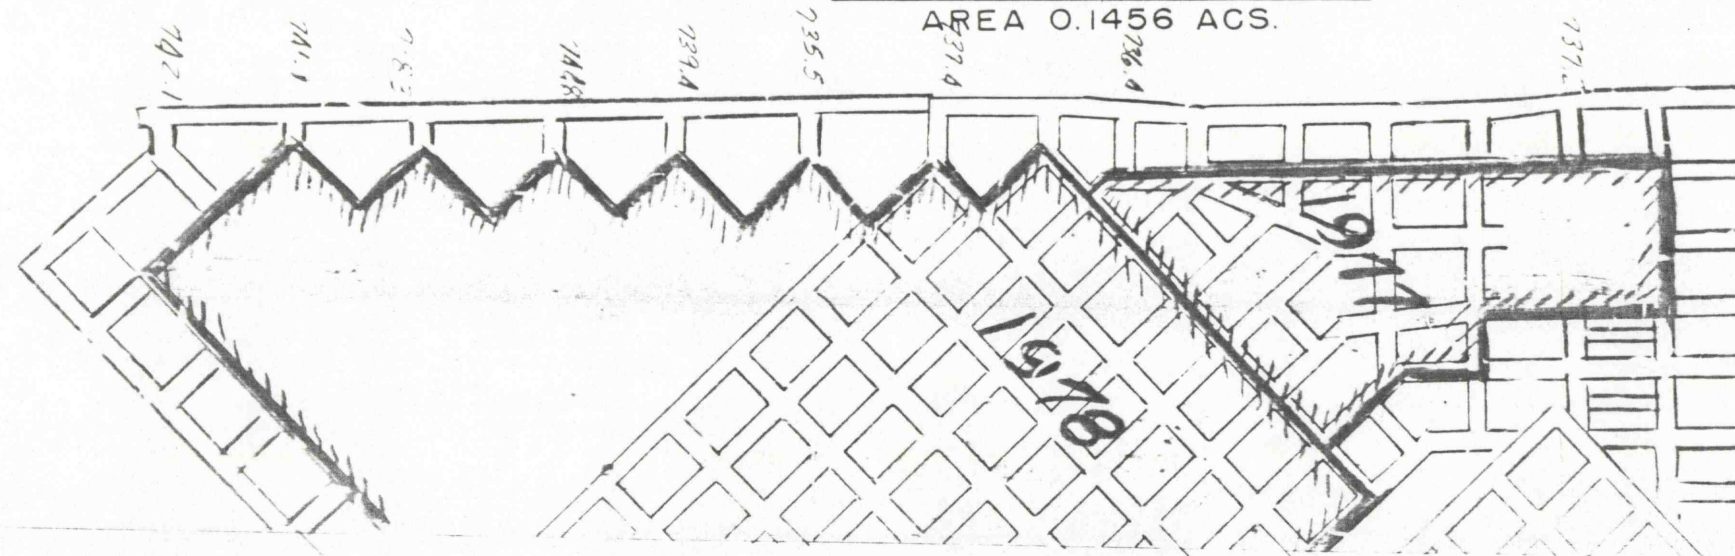


FIT TO 23

FIT TO 13

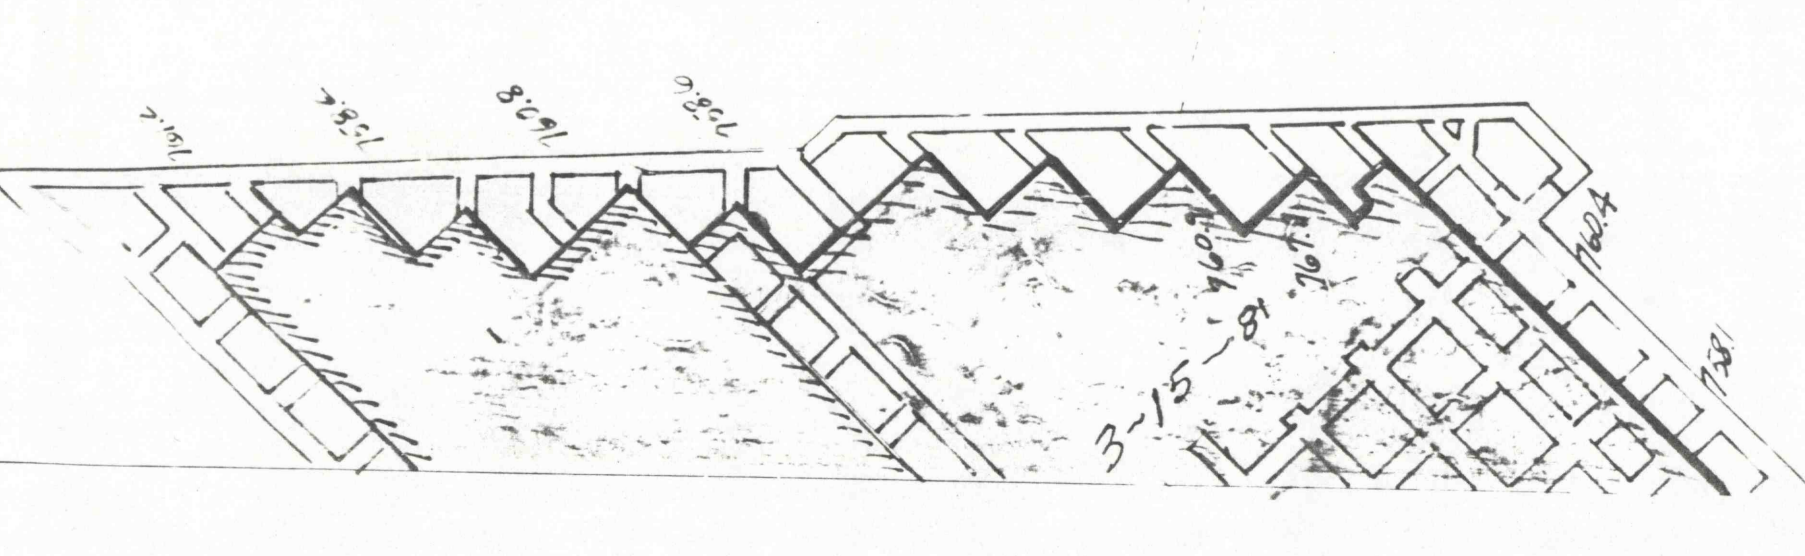

ELIZA JANE BEDALL
AREA 0.1456 ACS.

W. Harry Spwinger
05/06/02