
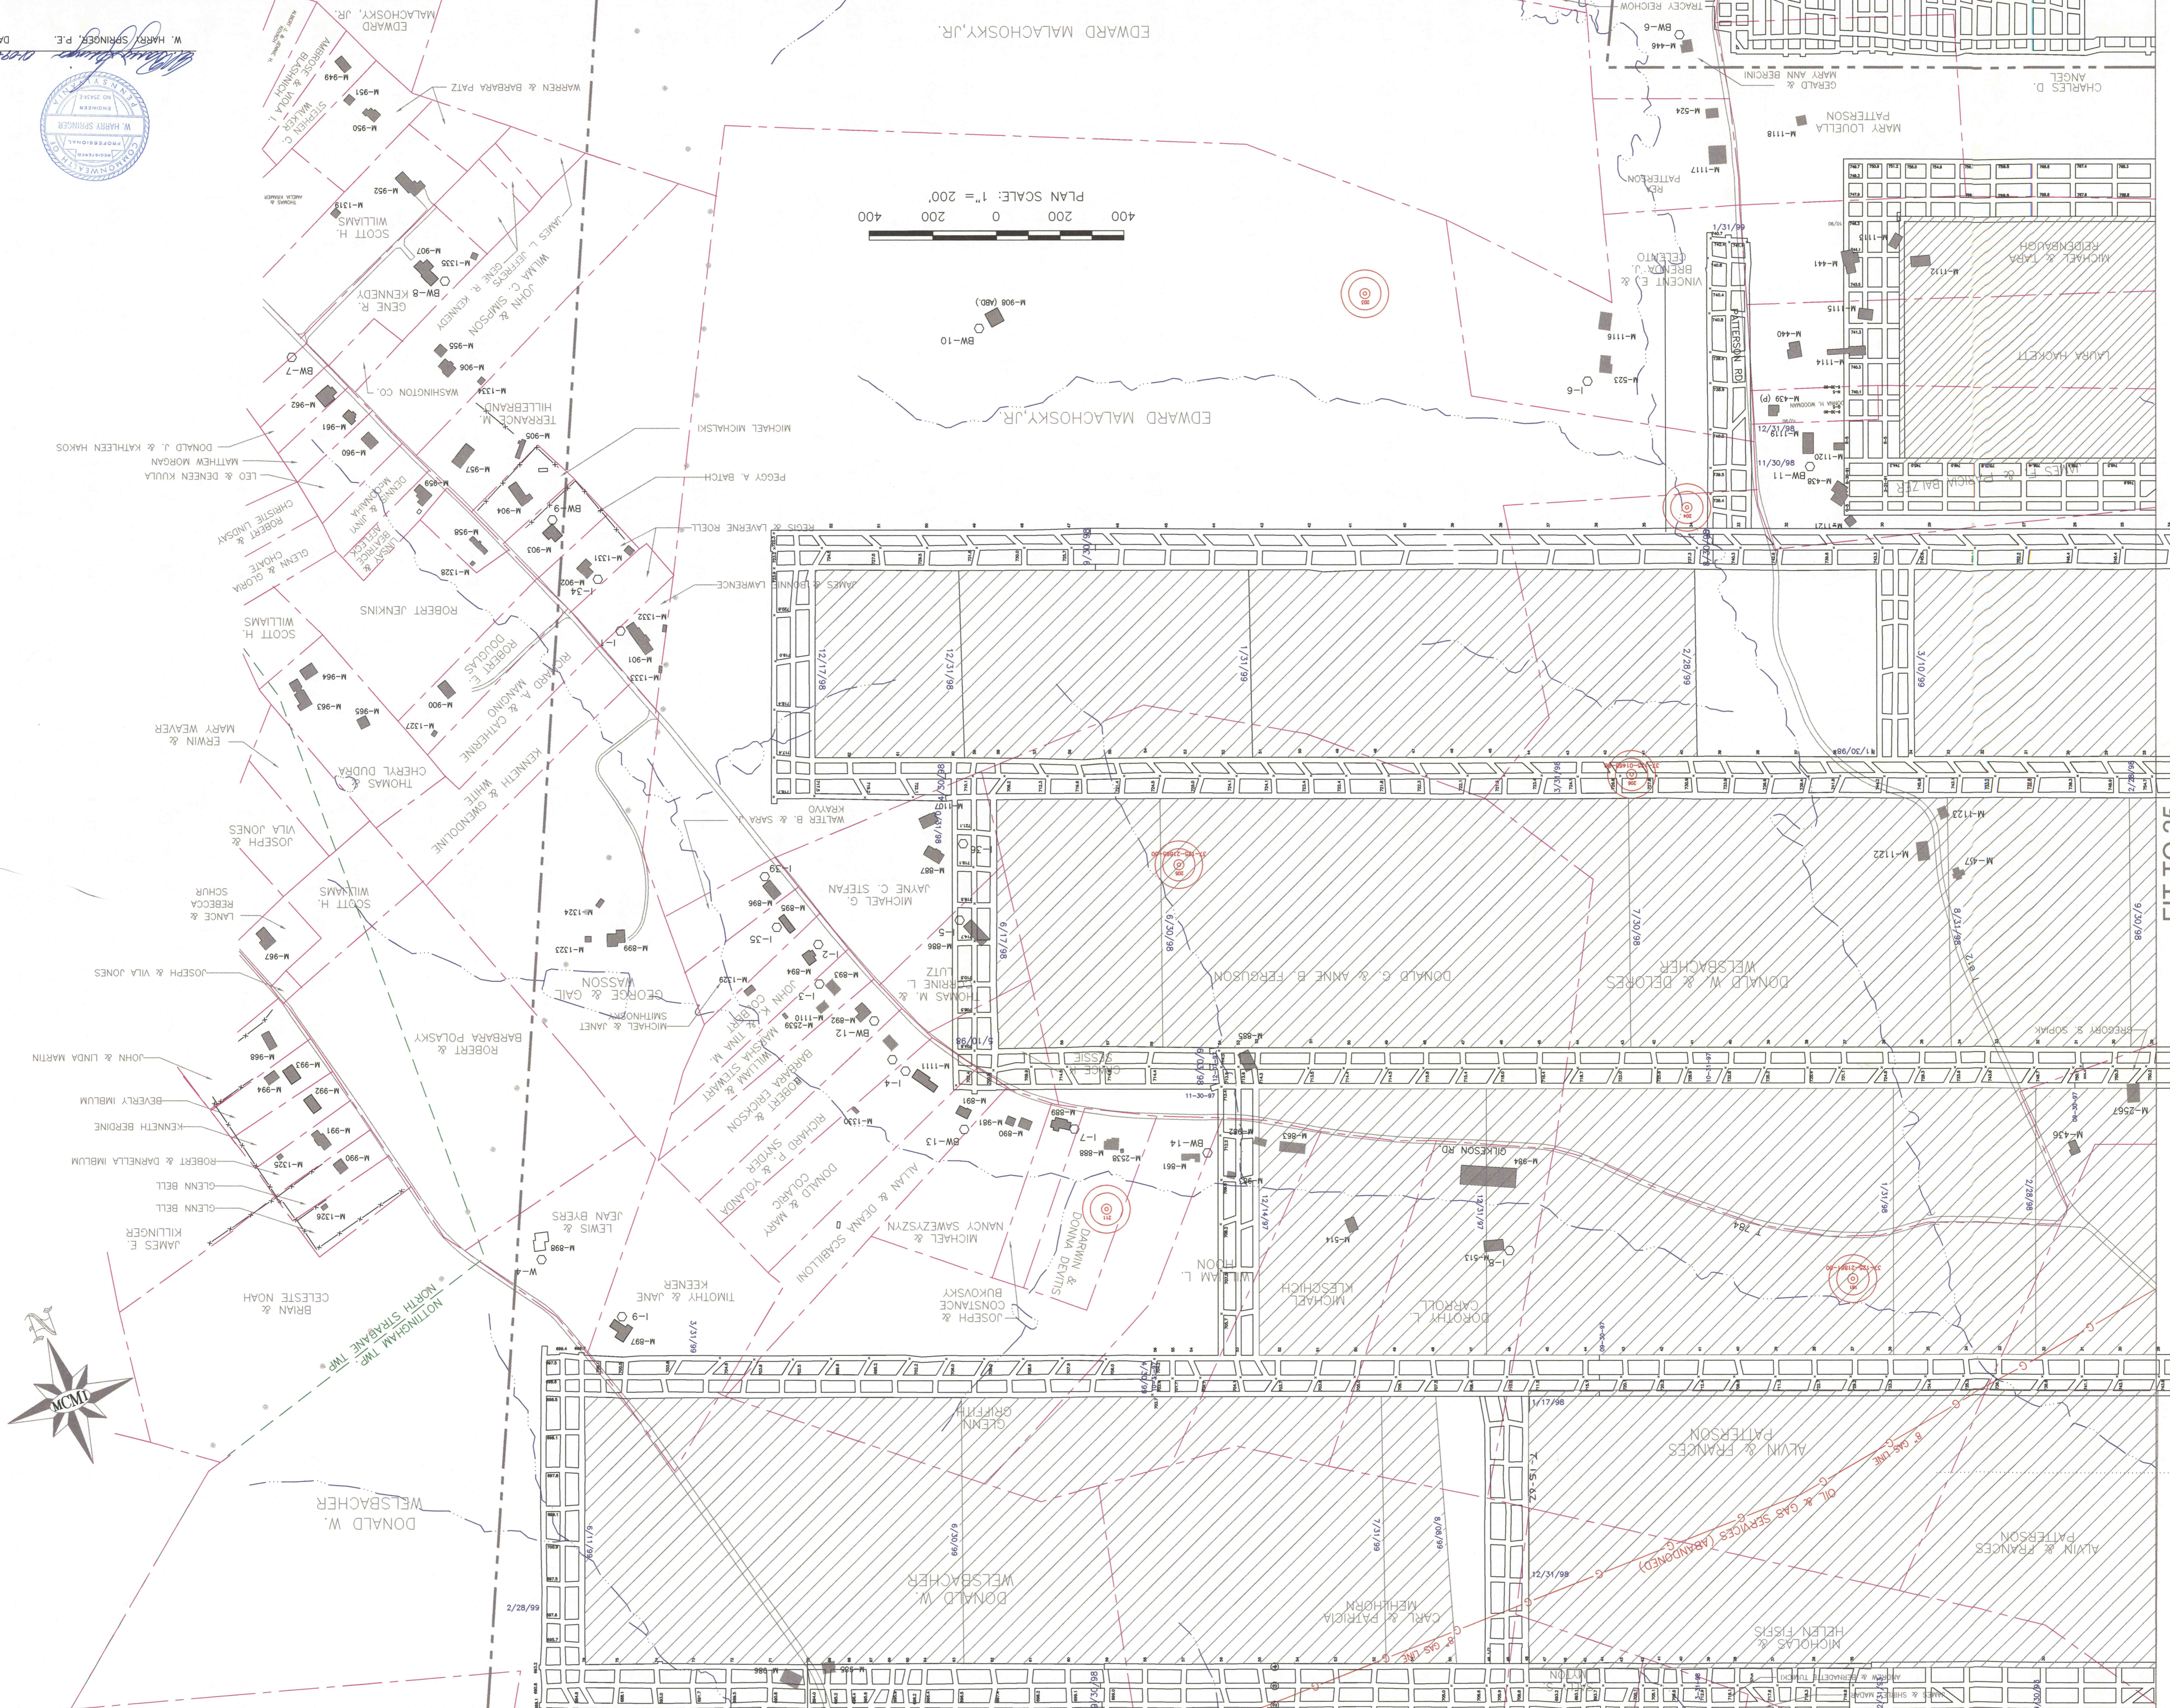


W. HARRY SPRINGER, P.E.
DATE

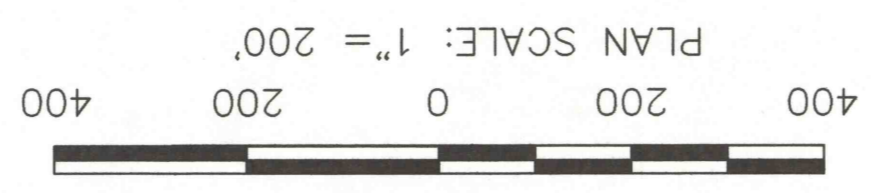

FIT TO 25

OIL & GAS SERVICES (ABANDONED)
OIL & GAS LINE