


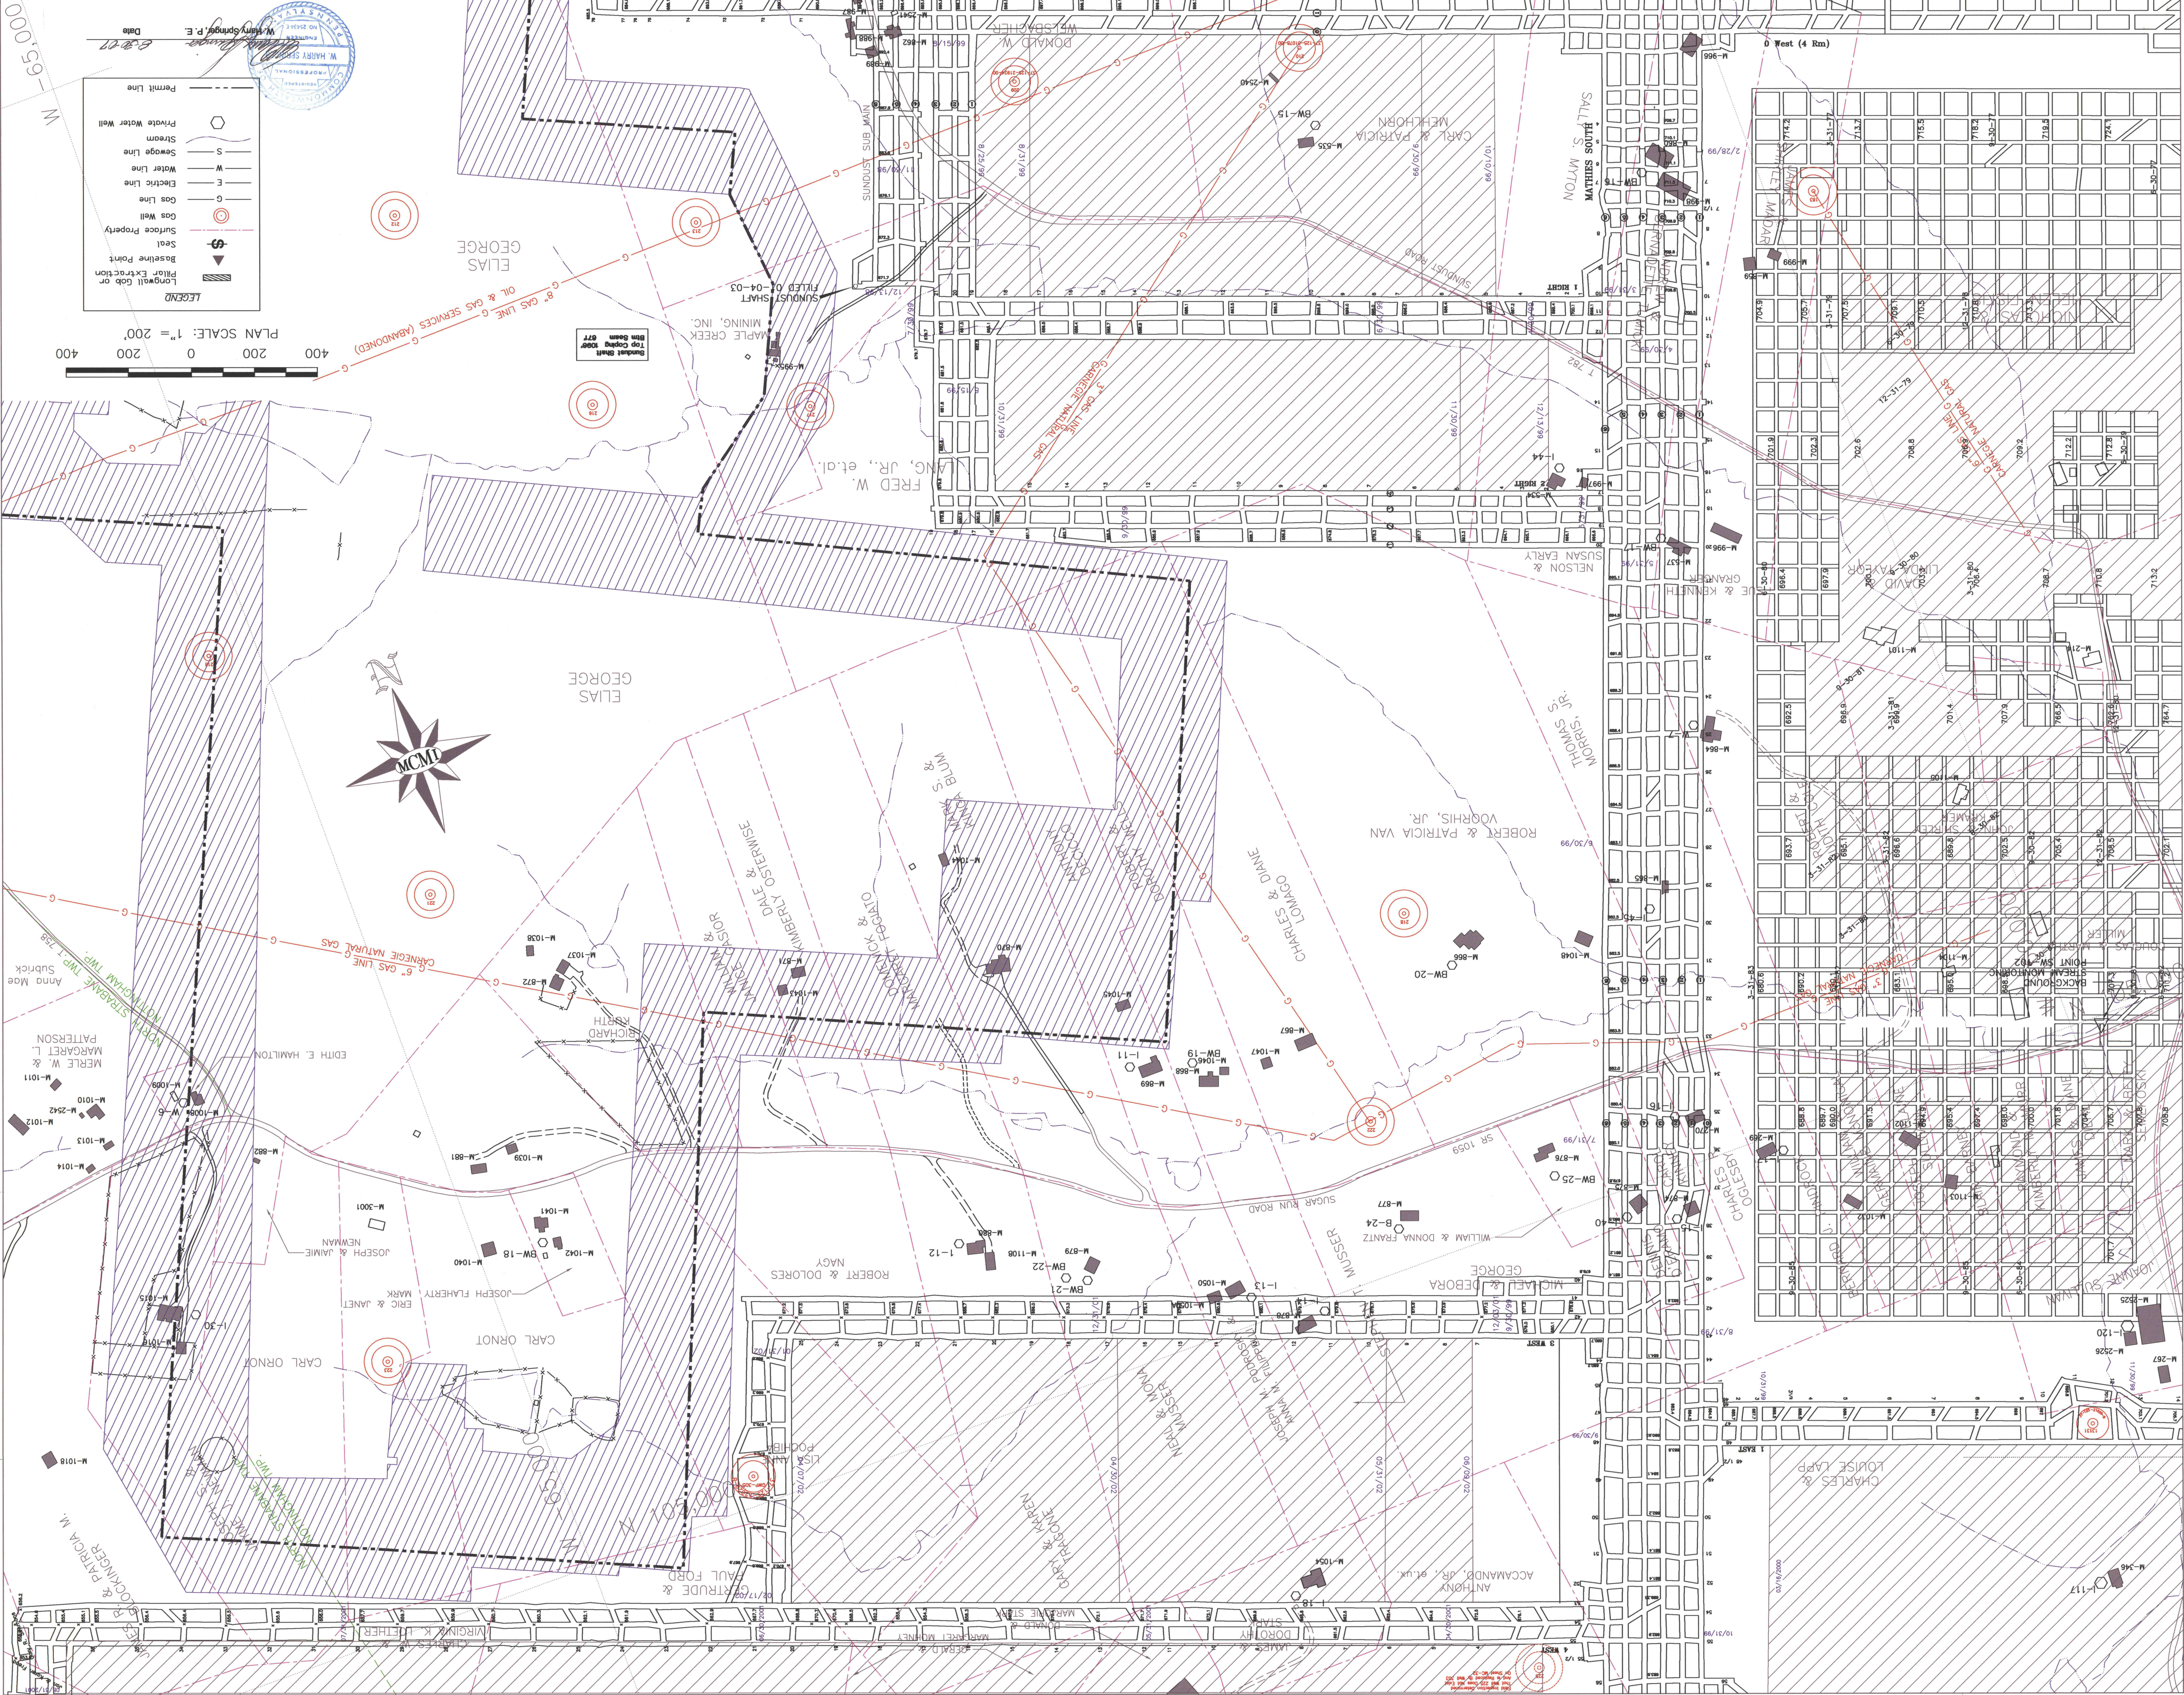

FIT TO 36

FIT TO 30

FIT TO 32

FIT TO 26