


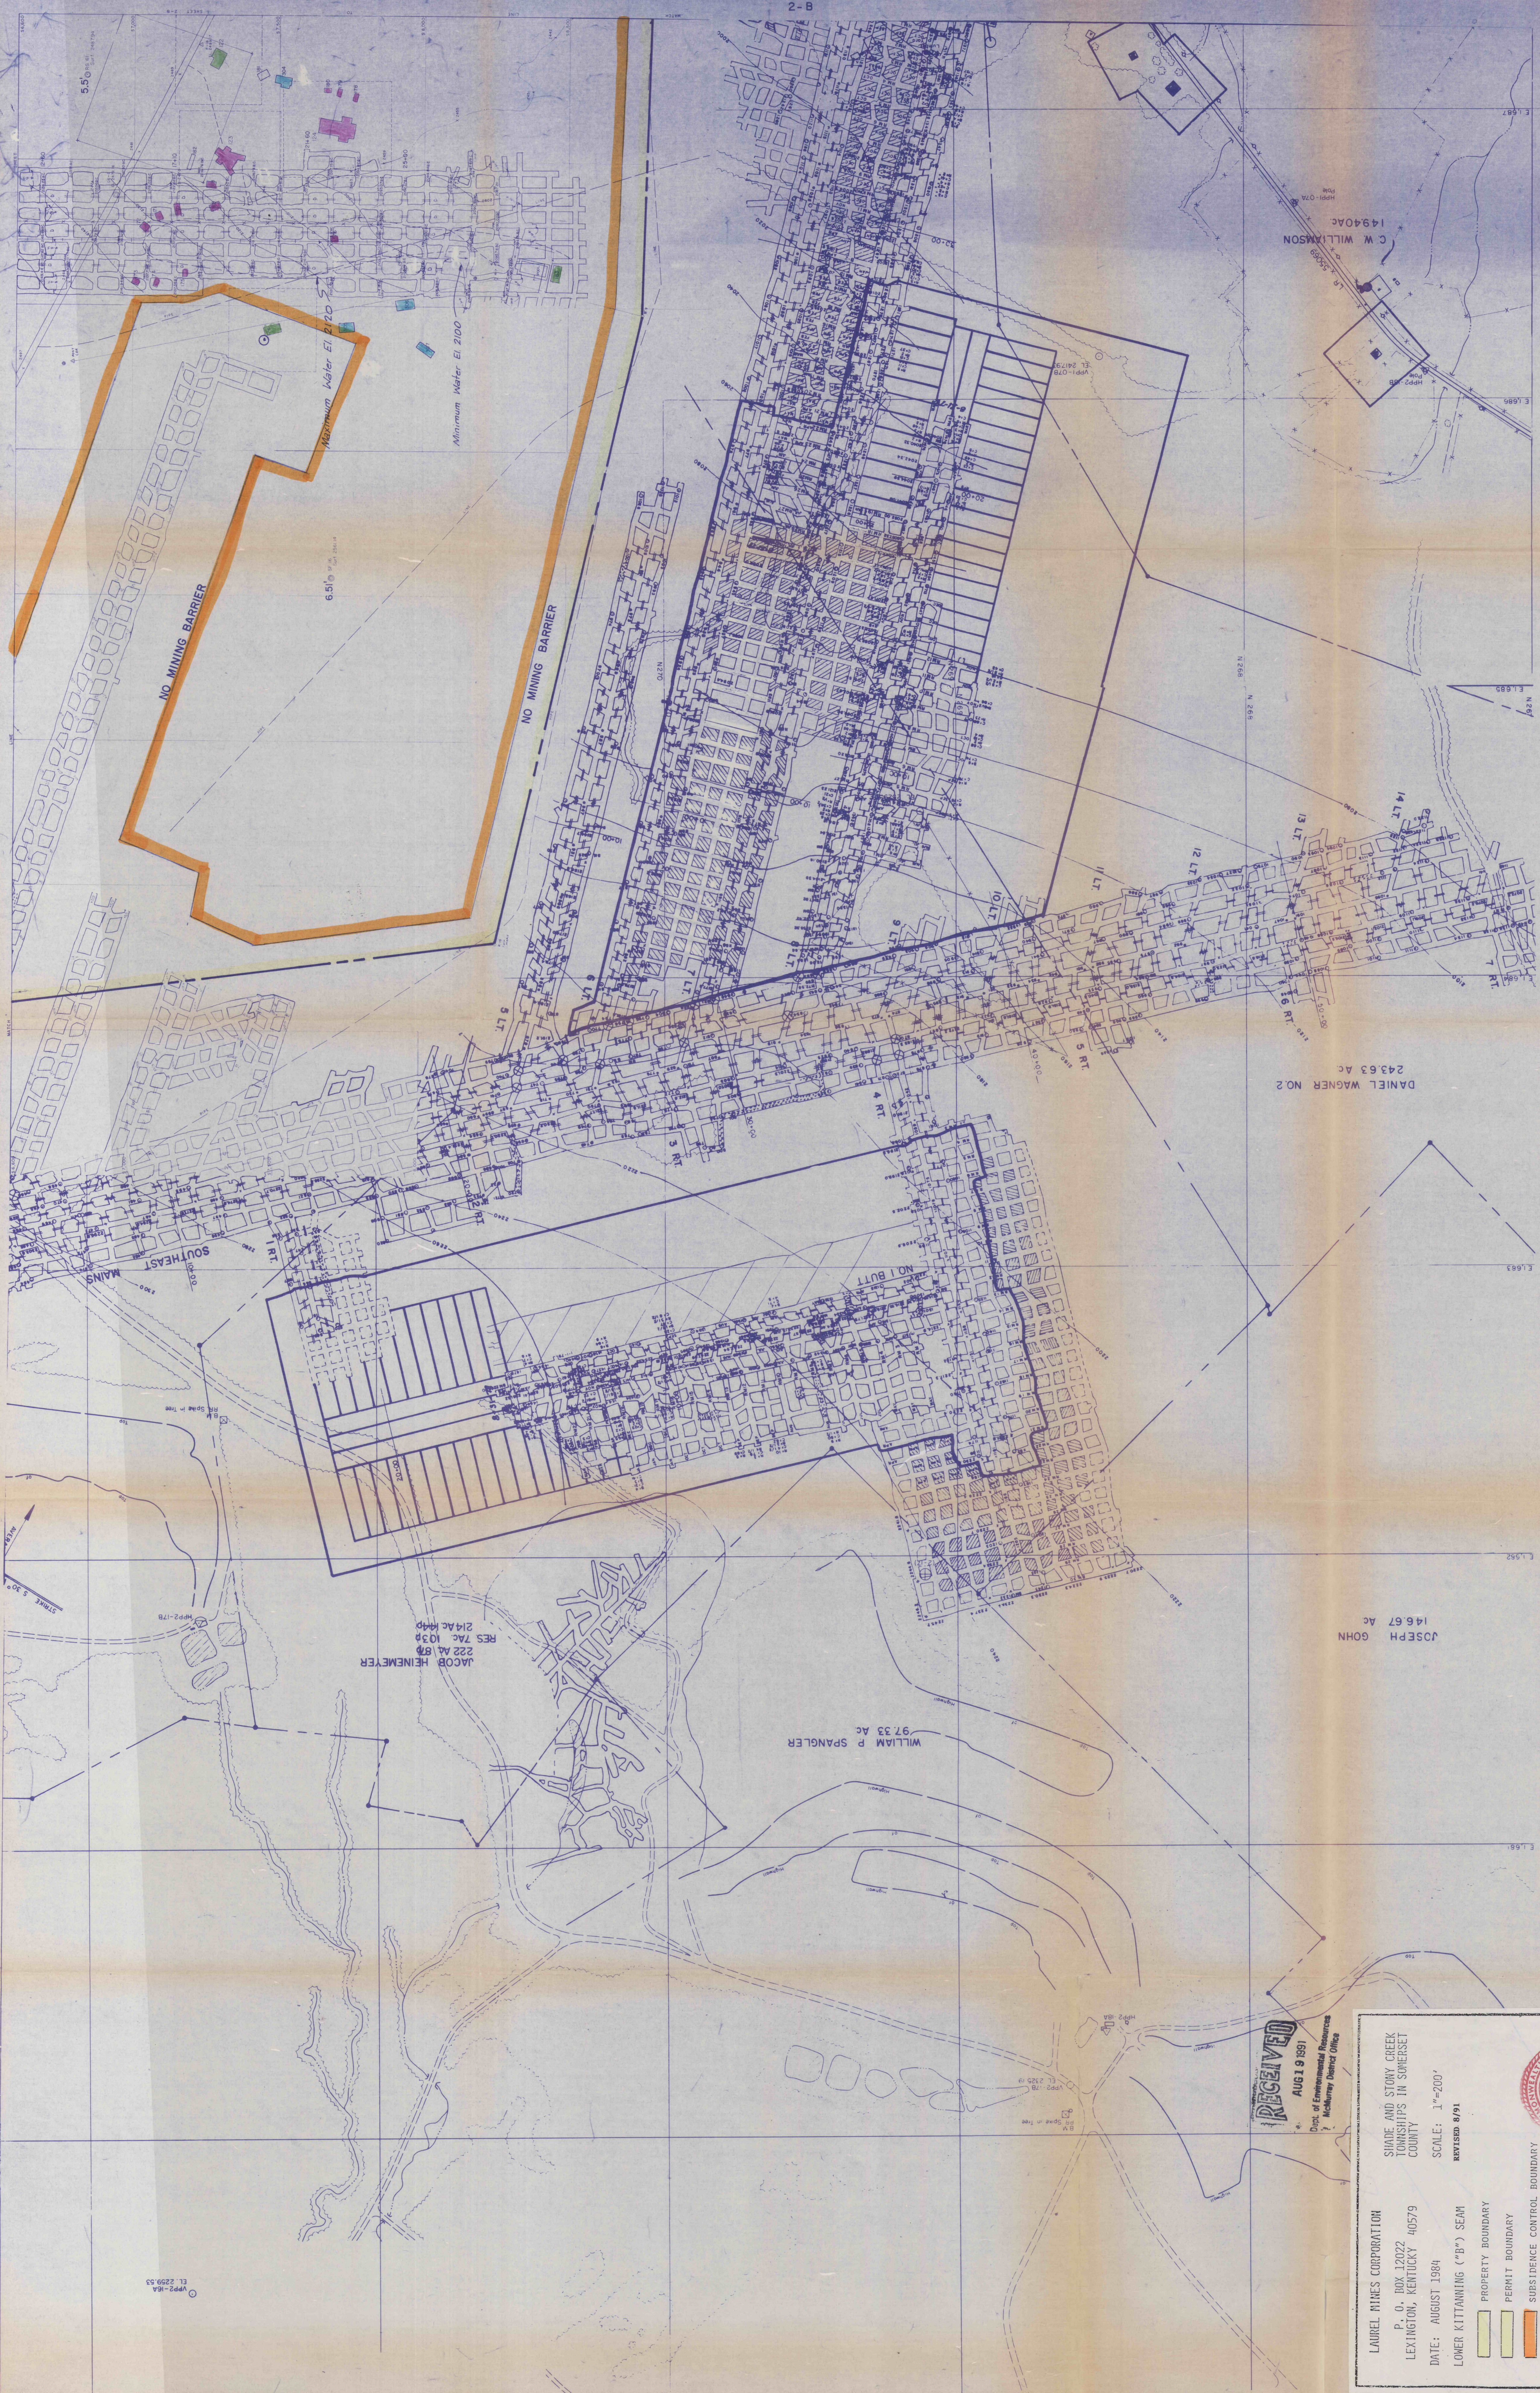

LAUREL MINES CORPORATION
P. O. BOX 12022
LEXINGTON, KENTUCKY 40579
DATE: AUGUST 1984
LOWER KITTANNING ("B") SEAM

RECEIVED
AUG 19 1991
Dept. of Environmental Resources

COUNTY
SCALE: 1"=200'
REVISED 8/91

PROPERTY BOUNDARY
PERMIT BOUNDARY
SUBSIDENCE CONTROL BOUNDARY
PRE - 1966 DWELLING
POST - 1966 DWELLING
PUBLIC BUILDINGS
PRE - 1966 CEMETERIES

CONFIDENTIAL
LINN MORRIS
ENGINEER
JULY 1991