



Parcel Number	Name
P1	Keystone Owner's Group
P2	Henderson, William E. & Sally J
P3	Craig, James W. & Carolyn K.
P4	Wilkinson, David J. & Mary Elle
P5	Parks, Wayne E. & Martha Z. (S&C)
P6	Heckman, Harold & Kay (S&C)
P7	Crawford, David J. & Dawn M.D.
P8	Crawford, David J. & Dawn M.D.
P9	Kutsch, Kevin M. & Sandy L.
P10	Milby, Howard R. & Jean
P11	Harkleroad, Howard C. & Linda M
P12	Graff, Clarence G. & Marie (S&C)
P13	Rearick, Kevin D. & Betsy M. (S&C)
P14	Elkin, Jay
P15	Sharp, Bruce A.
P16	EvaMae Redmond & Gregory McMeans
P17	Thomas, Raymond L. & Marilyn H.
P18	Mohney, Percy E. & Virginia D.
P19	Sharp, William P. Jr. & Samantha
P20	Bartosiewicz, Paul A. & Amanda
P21	Sharp, Samantha B.
P22	Russell, Dennis C. & Debbi L.
P23	Russell, Dennis C. & Debbi L.
P24	Ackerson, Daniel A. & Roberta E
P25	Blystone, Larry L. & Donna
P26	Elliot, Lois
P27	Johnston, Harold
P28	Jewart, Glenn W. & Sara G.
P29	Wofford, Paulette
P30	Beers, Karen
P31	Beers, Karen (S&C)
P32	Wofford, Paulette (S&C)
P33	Wofford, Paulette (S&C)
P34	Patterson, Dennis F. & Robin (S&C)
P35	Marasco, Robert D. & Sonza L. (S&C)
P36	Moyer, Eric E. & Brenda L. (S&C)
P37	Troutman, Ronald D. & Luann (S&C)
P38	Rearick, Douglas E.
P39	Walker, Jill C.
P40	Stewart, Thomas D. & Cindy L.
P41	Ashbaugh, John A.
P42	Robertson, Thomas Jr. & Bonnie
P43	Shearer, Alan R. & Brenda R.
P44	Bandi, William S. & Kathy R.
P45	Peteray, Thomas & Margaret
P46	Shaw, Gregory G. & Susan G.
P47	Fleming, Donald L. & Kathleen
P48	Miller, Wm. L. & Luella B. (S&C)
P49	Rosebud Mining Company
P50	Rosebud Mining Company
P53	Cellier, Francis & Marie
P66	Detwiler, W. Dale & Ruth A.
P67	Hill, David D. & Lorri J.
P68	Cosgrove, Margaret Ruth
P69	McCausland, Eleanor
P70	Spencer, Daniel Jr. & Linda D.
P71	Beatrice J. Blose, Samuel E.
P72	Blose, Edward M.
P73	Blose, Lillian R. & Edward M.
P74	Schall, Gerald F. & Karen S.
P75	Keystone Owner's Group
P76	Fleming Landscaping Co., Inc.
P77	Keystone Owner's Group
P78	Aikens, Martha (S&C)
P79	Bleakney, Robert & Charlesetta (S&C)
P80	Pinkerton, John E. & Beth A.
P81	Ankeny, Carolyn G.
P82	Smeltzer, Robert & Violet
P83	Frailley, Delbert & Elsie
P84	McClafferty, Sarah L.

	REGULATOR		COAL CONTOUR
	STOPPING WITH MAN DOOR		PROPERTY LINE
	PERMANENT STOPPING		PERMIT BOUNDARY
	GAS WELL (PERMITTED)		SUBSIDENCE CONTROL PLAN BOUNDARY
	GAS WELL - SURVEYED		100 FT. COVER LINE
	POSSIBLE GAS WELL SITE		P27 LANDOWNER MAP PARCEL NUMBER
	SURVEY POINT - UG		SANDSTONE CHANNEL
	CHECK SURVEY POINT - UG		FIRST MINING ONLY
	SURVEY POINT - SURF		NO MINING - BARRIER AREA
	DRILLHOLE		DWELLING
			STRUCTURE (OTHER)

CLOSED LOOP SURVEY
PRECISION: NOT LESS THAN 1:10,000
THERE ARE NO UNDERGROUND MINES WITHIN 1000 FT. OF PERMITTED ARE.
INTERVAL BETWEEN UG & LK SEAMS APPROX 210'
THIS MAP COVERS CFR 75.1200 AND 75.372
MINES IN SAME SEAM OR IN OVERLYING SEAMS WHICH ARE WITHIN 1000 FT. OF EXISTING AND PROJECTED MINING ARE SHOWN ON THIS MAP
Person responsible for map information: Dennis E. Greble
MINING COMPLETION DATE: JULY 7, 2008
FINAL SURVEY DATE: JULY 24, 2008
COORDINATE SYSTEM: PA SOUTH ZONE, NAD 83
VERTICAL DATUM: NAVD83

This final mine map represents a complete and accurate representation of all Keystone East Mine underground excavations.

J. Clifford Forrest, President 11-04-08 date
Dennis E. Greble, Manager of Engineering 11-04-08 date

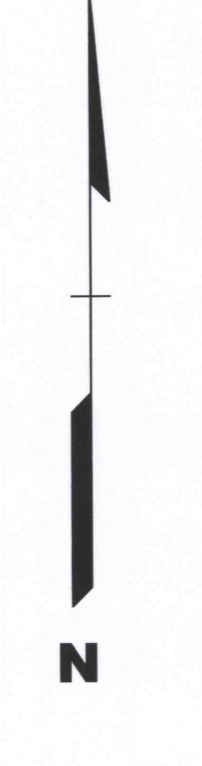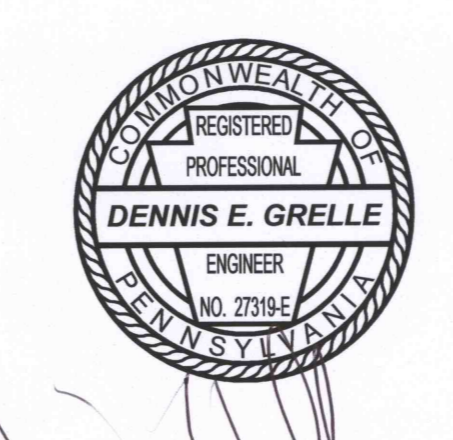

Rosebud Mining Company
KEYSTONE EAST MINE
FINAL MAP
Upper Freeport Coal Seam

Plumcreek Township, Armstrong County, PA
2263 Copper Valley Road
Shelcta, PA 15774
ID No. 36 09193 CMAP No. 03031301
Scale: 1 in. = 200 ft.