


- 1 The information on this map is accurate to the best of my information, knowledge, and belief.
- 2 The certification of this map is based on prior certifications.
- 3 Original mapping done by Musser Engineering, Inc.
- 4 Grids are located on PA State Plane Coordinate System South Zone 1927 NAD.
- 5 Distance between U.F. coal & U.K. coal is approx. 90'. Distance between U.F. coal & Monongahela coal is approx. 50'.
- 6 Mining centers under the post office and church will be 50' X 120'.
- 7 Check surveys listed on sheet 1.

Legend	
Underground Permit & Subsidence Control Plan Boundary	
Surface Permit Boundary	
Six Month Projection Line	
30' Angle of Draw Line	
Previous six month's mining Dwellings	
Other Buildings	
Class I Protected Structure	
Upper Freepoint Contours	
Surface Property Line	
Surf. Prop. I.D. No.	
Exploration Drillhole	
First Mining Area	
UK Deep Mine Boundary	
UF Deep Mine Boundary	
Public Road	
Non-Public Road	
Perennial Stream	
Intermittent Stream	
Ephemeral Stream	
Public Water Lines	
Utility Lines	
Deep Mine Entry	
500' drill line	
Restricted Mining Area < 100' Cover	
Mining Widths will be limited to 20'	

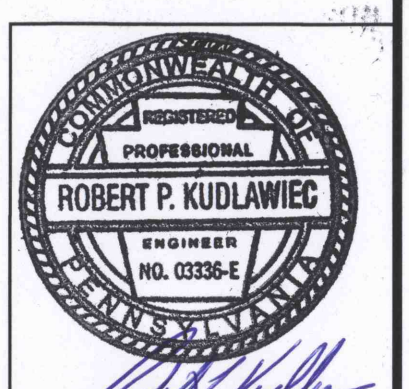

RoxCoal, Inc.
 Miller Mine
 CMAP#: 56961302
 Upper Freepoint (E) Coal Seam
 Jenner & Lincoln Twp., Somerset County
 Final Six Month Projection Map
 Sheet #2 of 2

Final Mining Date: 2-13-10
 Survey Date: 2-15-10
 Scale: 1" = 200'

RECEIVED
 AUG 17 2010
 Dept. of Environmental Protection
 Pittsburgh District Office