
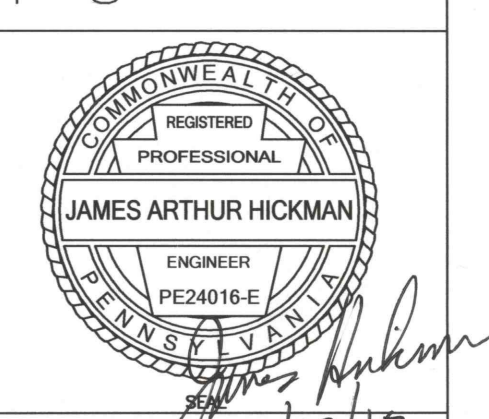


FINAL MAP FOR:
 ROXCOAL, INC.
 GERONIMO MINE
 LOWER KITTANNING SEAM
 PERMIT# 56971301
 MSHA ID# 3608645
 MINE ADDRESS:
 5815 PENN AVE.
 STOYSTOWN, PA 15563
 DATE: 10-25-10
 SCALE: 1"=200'
 SHEET 3

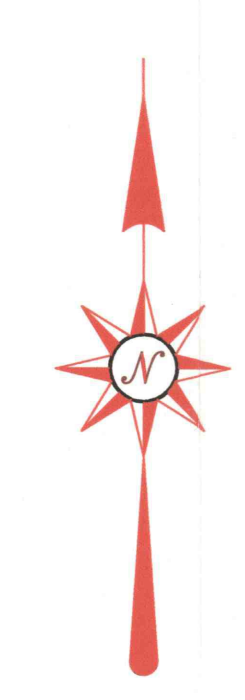

The information on this map is accurate to the best of my knowledge, information, & belief. The certification of this map is based on prior map certifications.

This map represents the complete and accurate location of all excavations and is the final map. Final wells have been installed.

James Arthur Hodman
 Corporate Officer

