


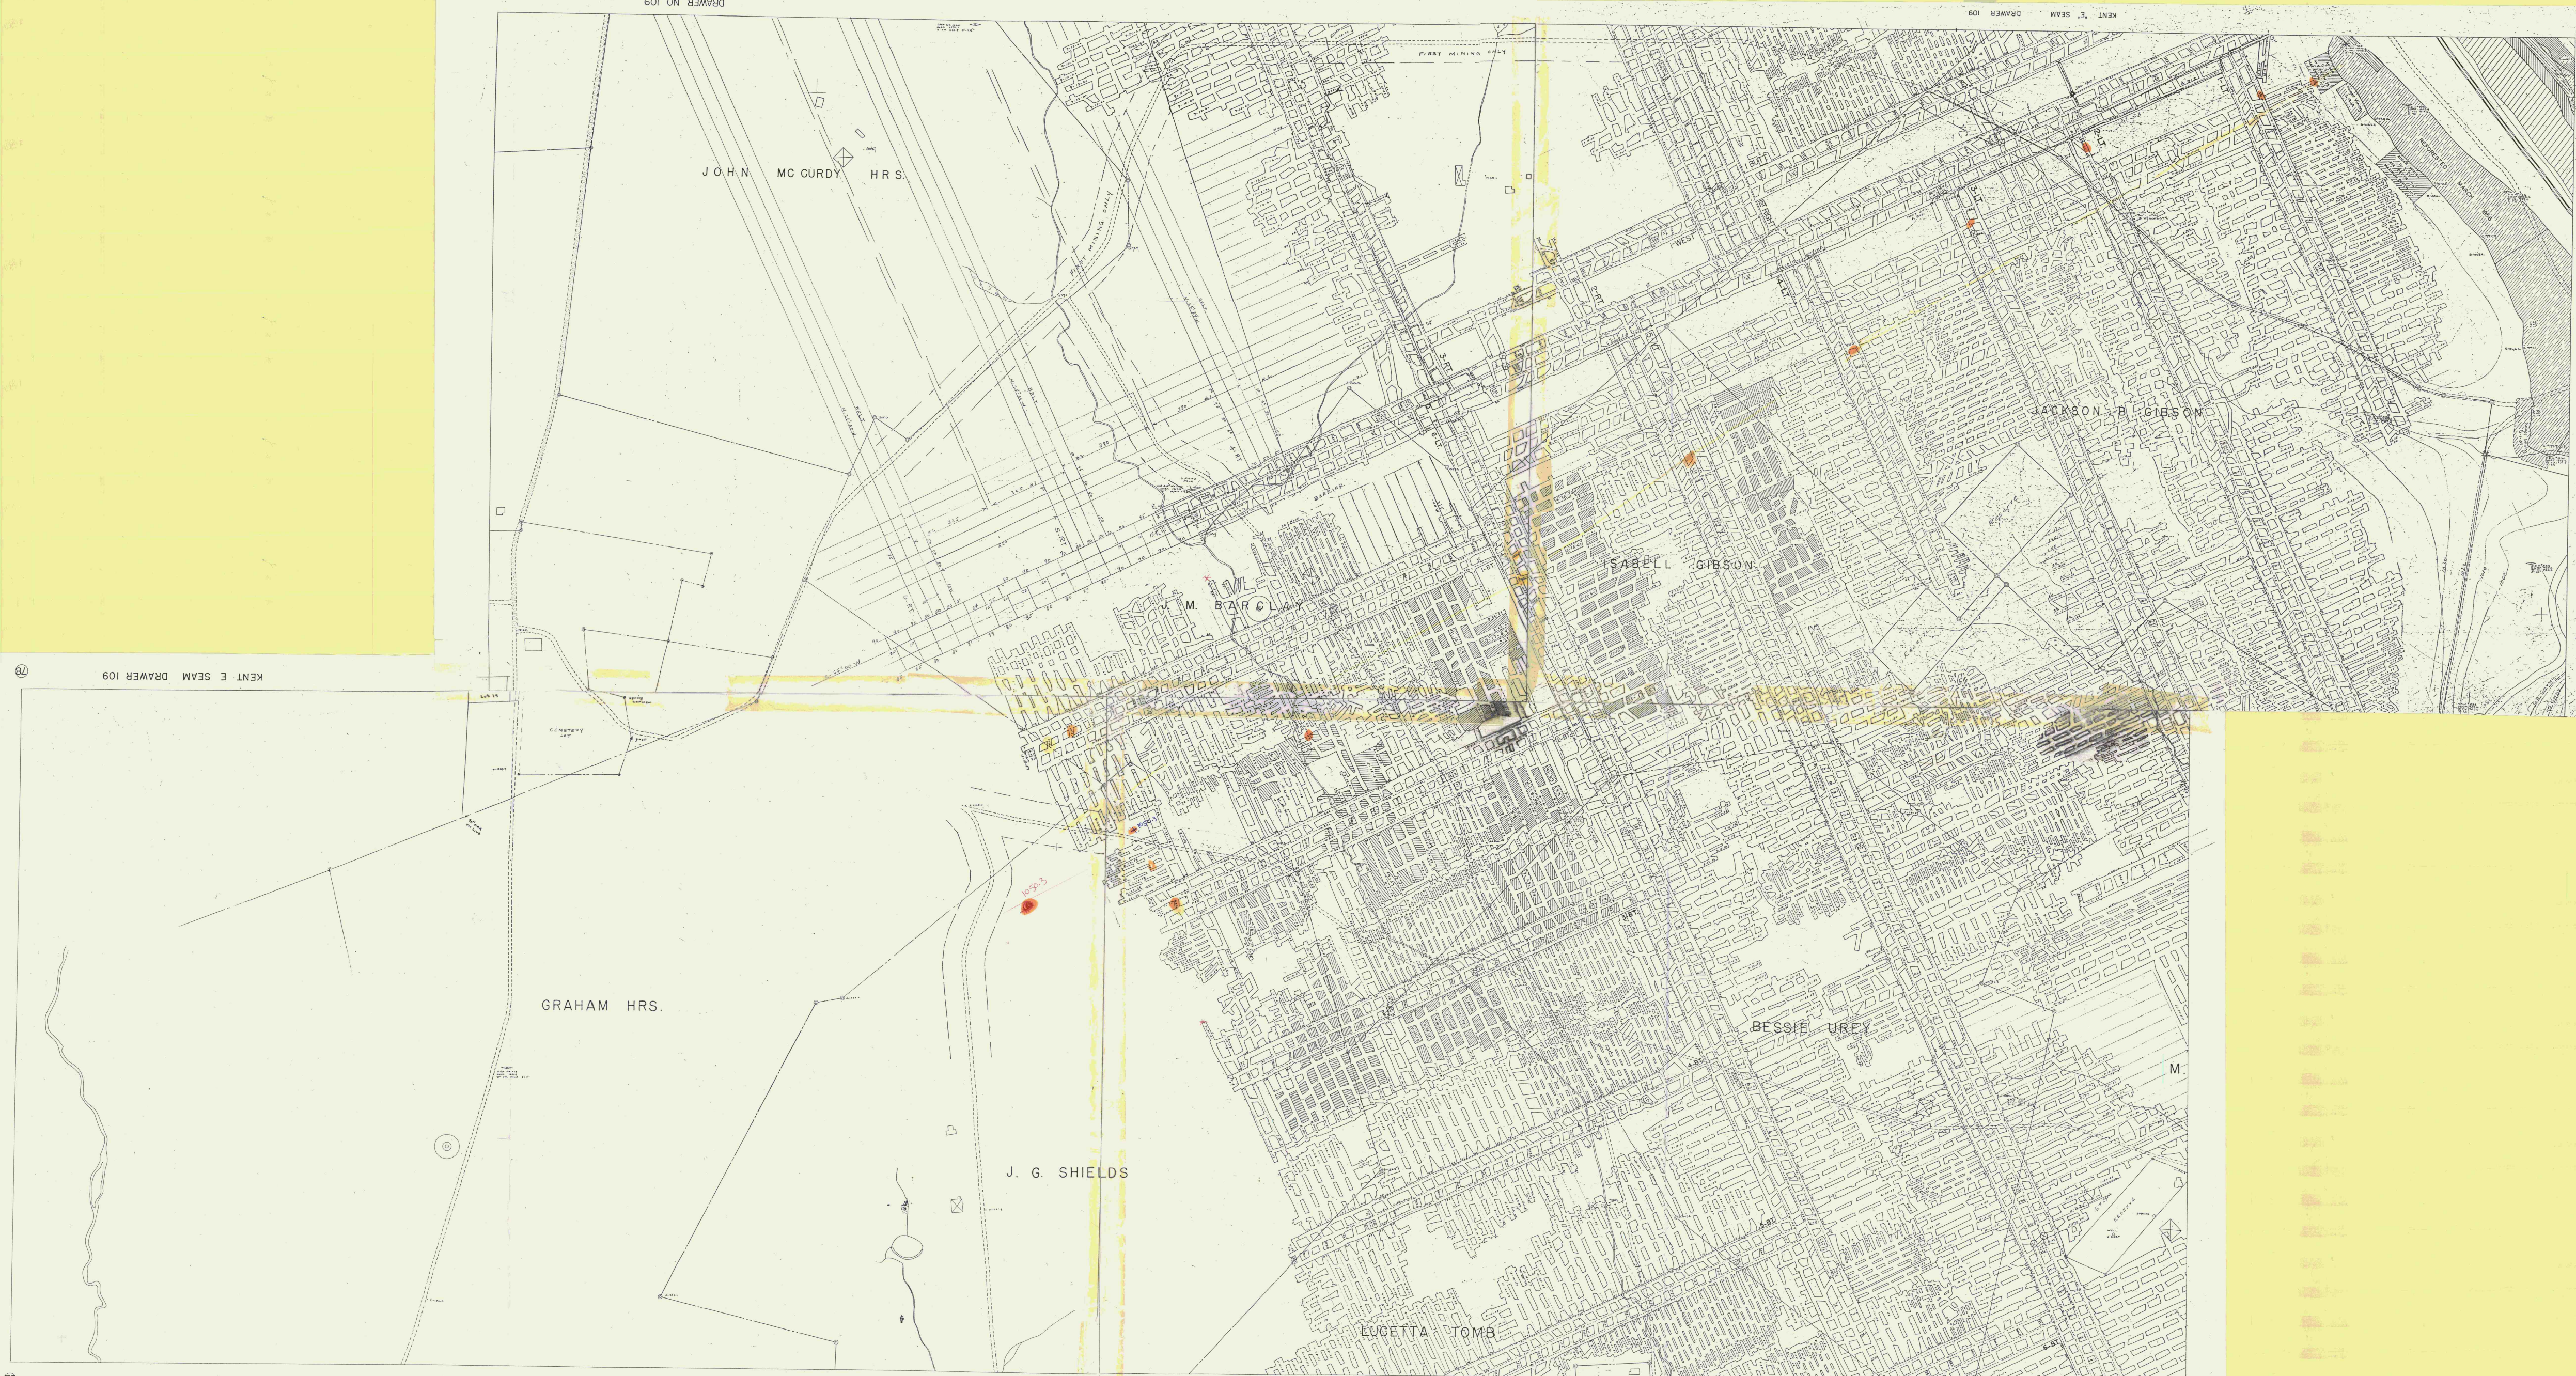

76
KENT E SEAM DRAWER 109

78
KENT E SEAM DRAWER 109
BASEMENT FILE
76
76

KENT E SEAM DRAWER 109
BASEMENT FILE
76

HELVETIA COAL COMPANY
CLARKSBURG, INDIANA COUNTY, PA.
Scale 1" = 200' Date 11-9-25

HELVETIA COAL COMPANY
CLARKSBURG, INDIANA COUNTY, PA.
Scale 1" = 200' Date 11-9-25