


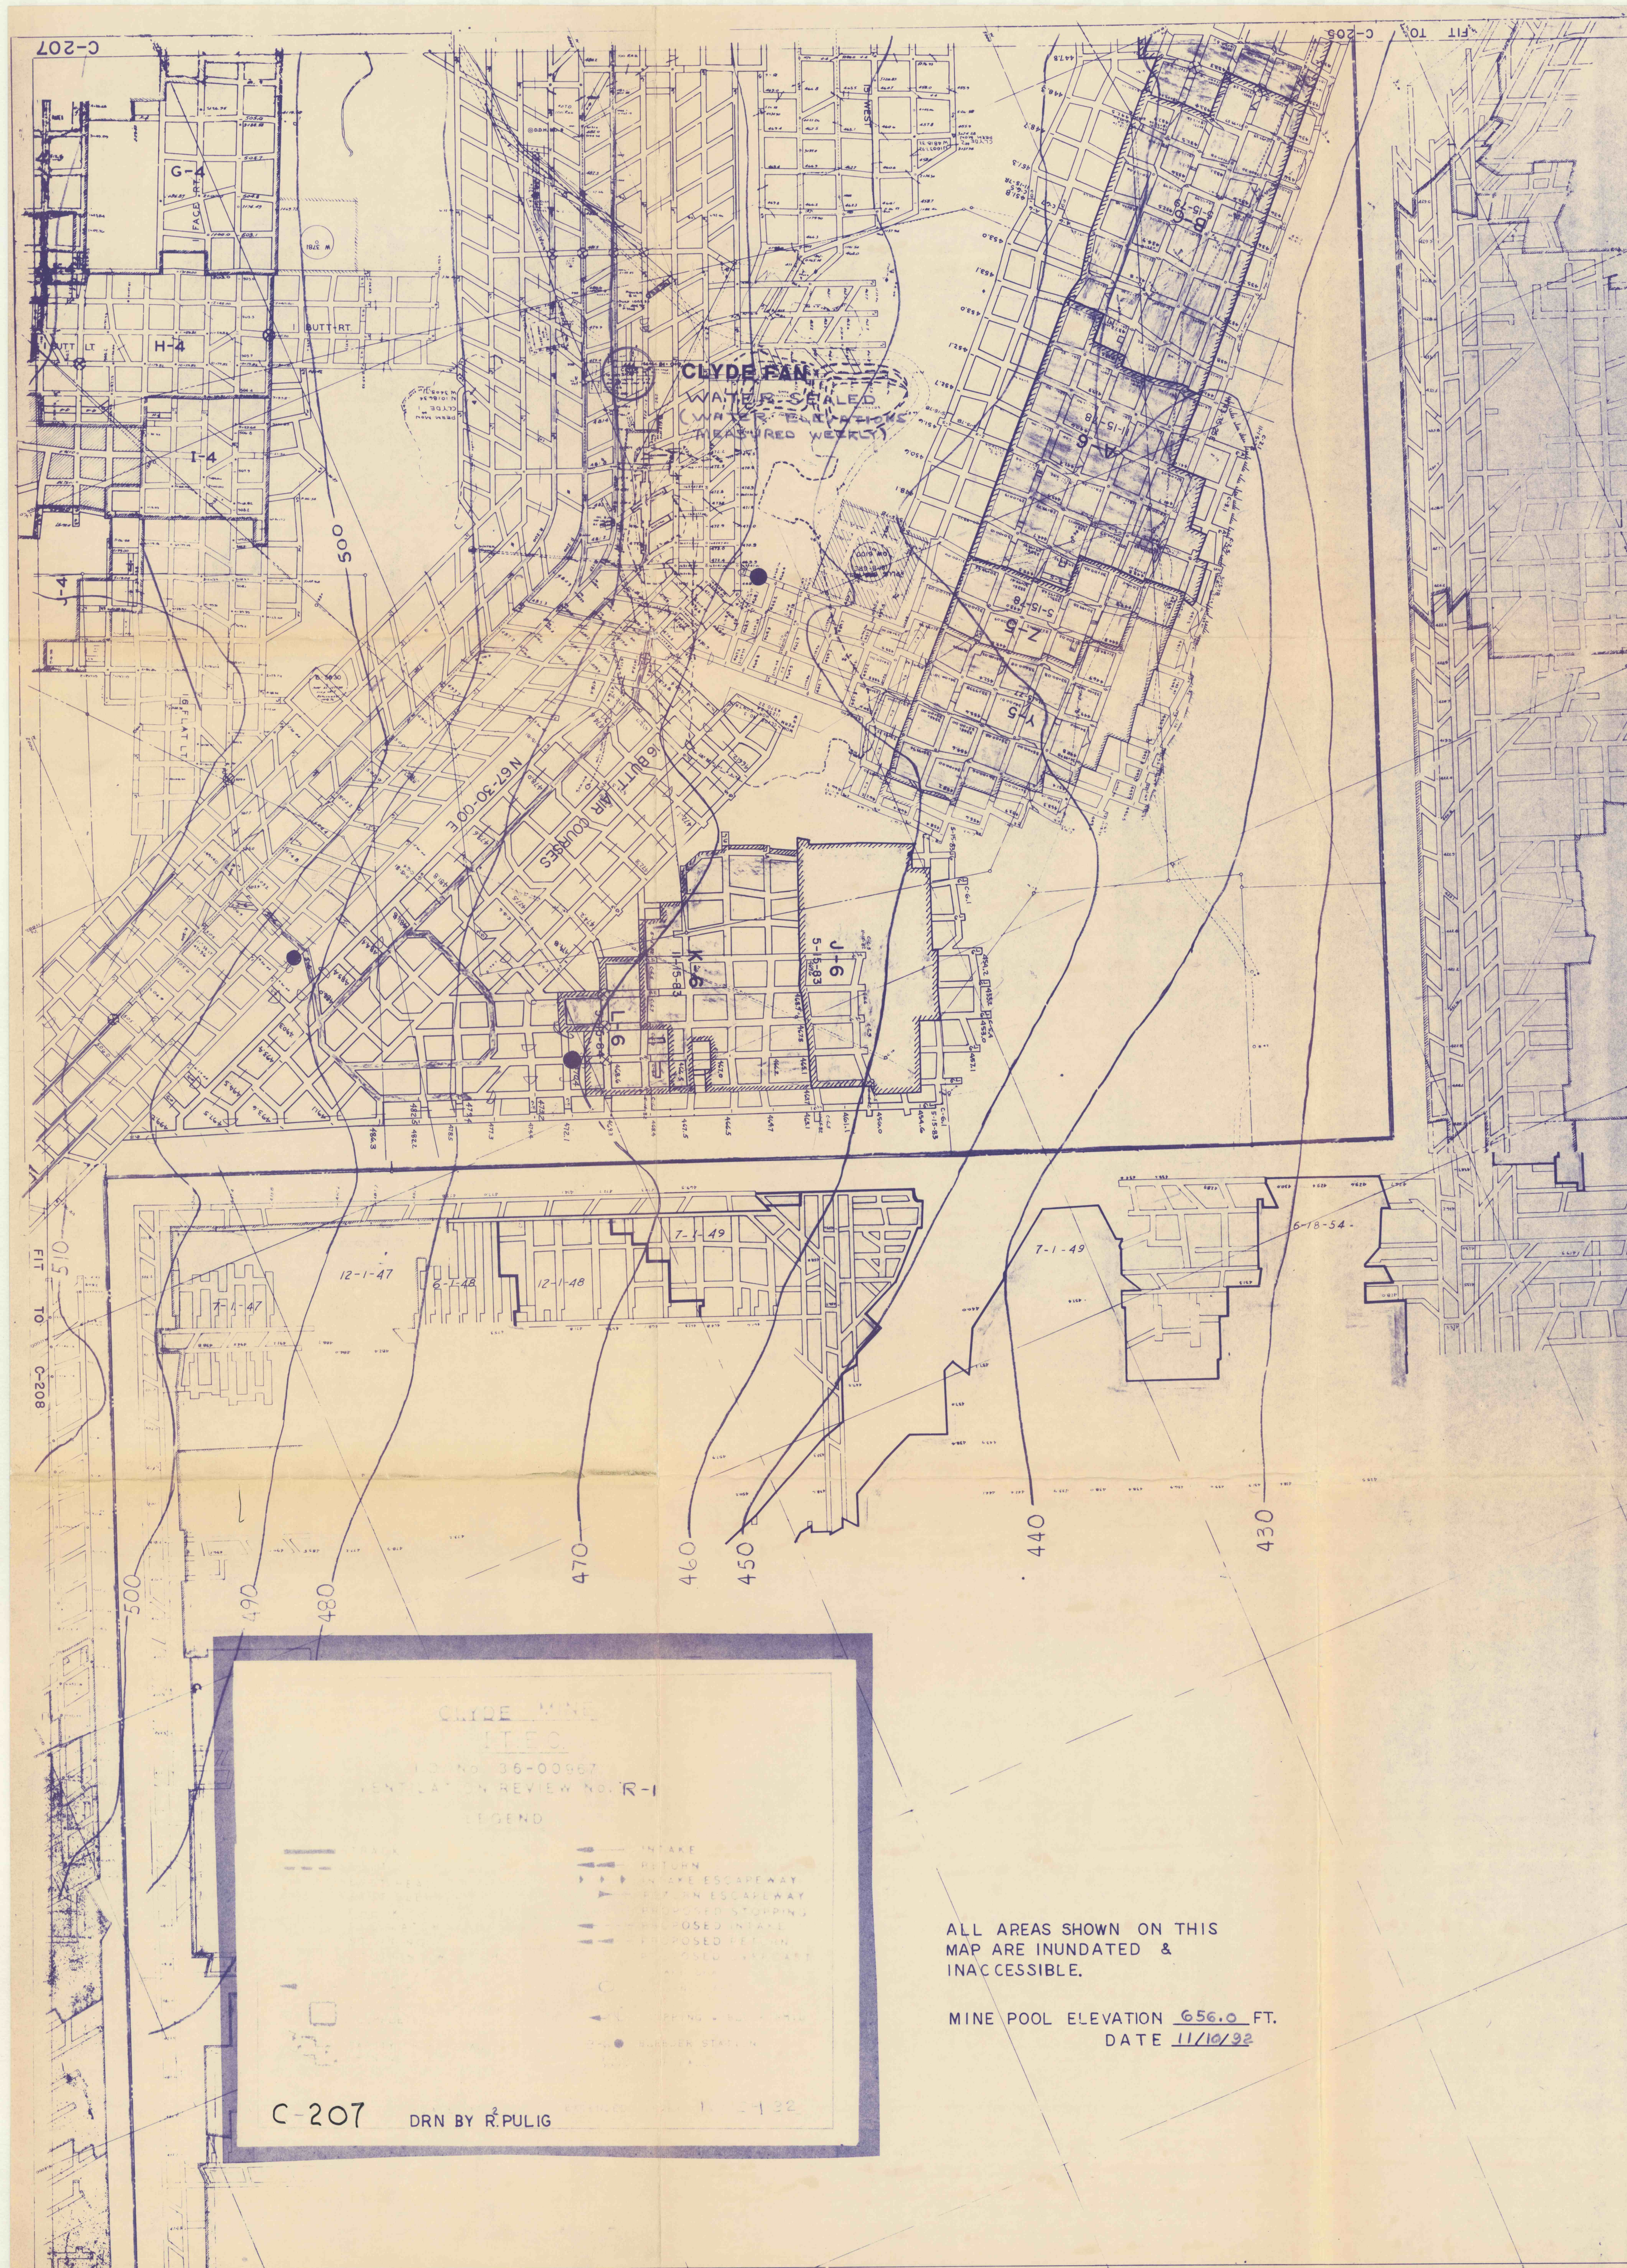

C-207

DRN BY R. PULIG

ALL AREAS SHOWN ON THIS
MAP ARE INUNDATED &
INACCESSIBLE.

MINE POOL ELEVATION 656.0 FT.
