Goes with this 1 sheet

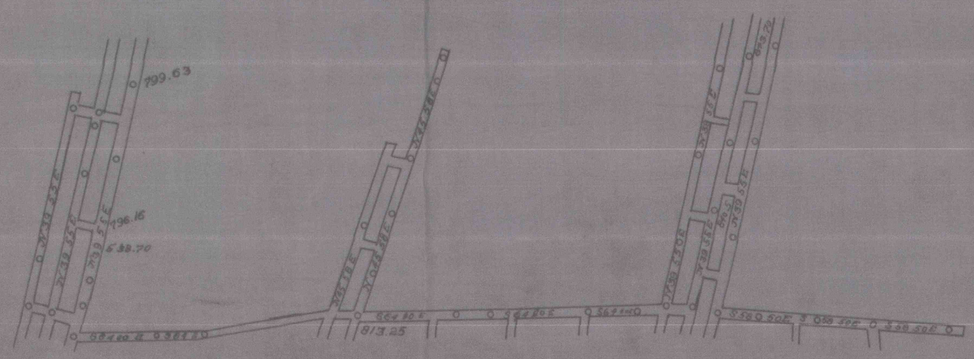

5458