
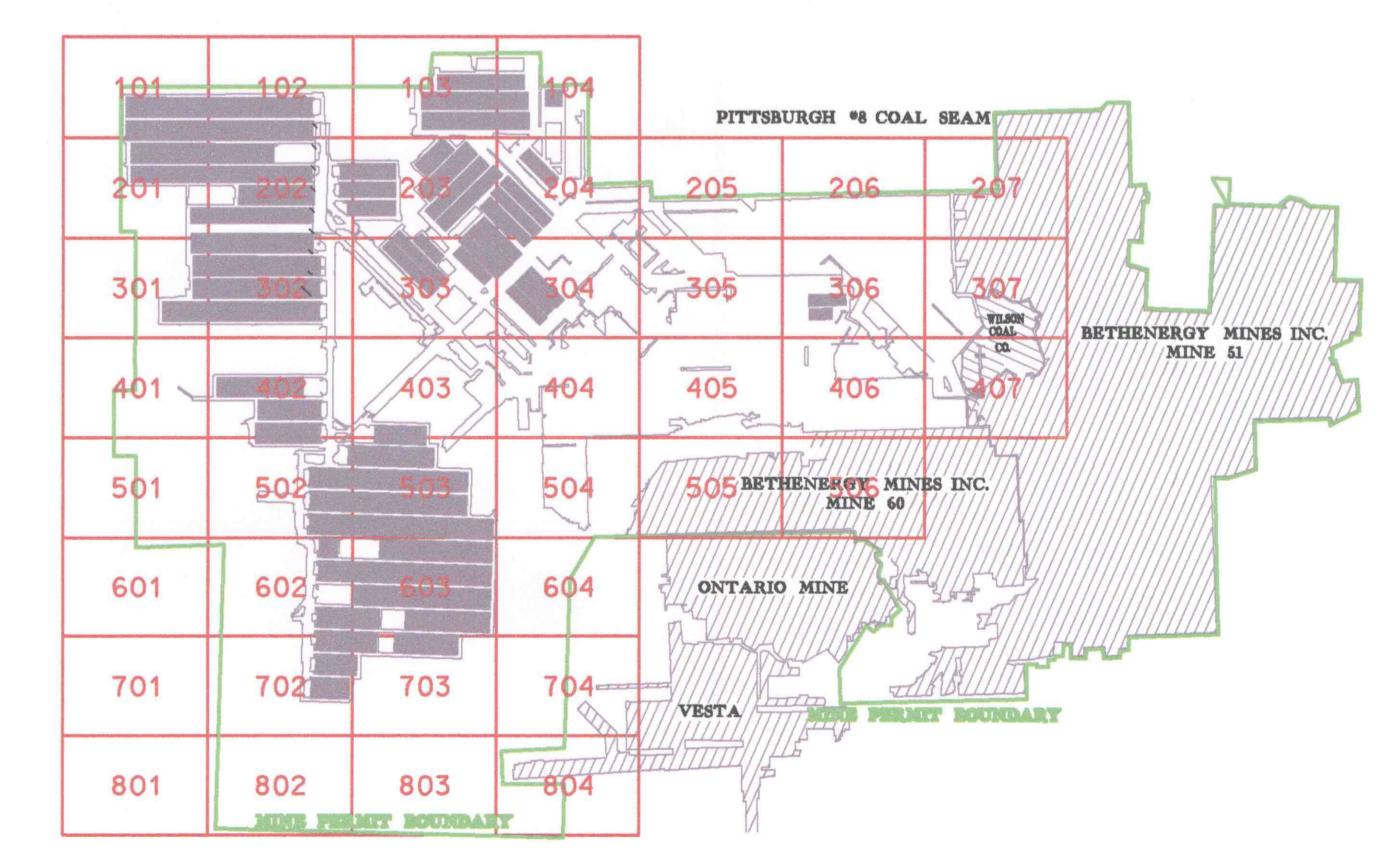


MATCH TO SHEET 103

MATCH TO SHEET 204

SHEET 104

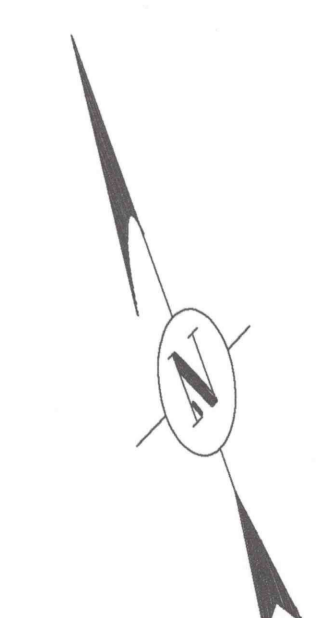

This map submitted in accordance with 30 CFR Sec. 75.1204 & PA Act 58 949 Sec. 228
 PERSONS PROVIDING INFORMATION ON MAP:
 MARK HRUTKAY, MINE FOREMAN
 NATHAN WOODS, MINE ENGINEER TRAINER

INFORMATION INCORPORATED IN THIS MINE MAP WAS PROVIDED BY THE OPERATOR AND PREVIOUS OPERATORS AND MAY NOT HAVE ALL BEEN VERIFIED OR EVALUATED BY THE UNDERSIGNED. THE MAP MAY ALSO INCORPORATE THE SURVEY RESULTS AND MAPPING PREPARED UNDER THE DIRECTION OF REGISTERED ENGINEERS OTHER THAN THE UNDERSIGNED, SUBJECT TO THE APPROPRIATE QUALIFICATIONS, TO THE BEST OF MY KNOWLEDGE AND BELIEF. THIS DRAWING CONTAINS ACCURATE INFORMATION AND HAS BEEN COMPILED IN ACCORDANCE WITH GOOD ENGINEERING PRACTICES. AS OF MARCH 19, 2005, MINE MAPS PREPARED BY STANDARDS ACCORDING TO PA DEP TID. NO. 663-2000-910 SEC. 22.8 PENNSYLVANIA STATE PLANE COORDINATE GRID (NAD83 DATUM).

CHAIN OF OWNERSHIP:
 OWNER/LESSOR
 RESERVE COAL PROPERTIES CO. 11/16/2001 - PRESENT
 LUCINE LAND CO. 12/30/1989 - 11/16/2001
 BETHLEHEM STEEL CORP. 12/24/1988 - 12/30/1992
 CONSOLIDATION COAL CO. 05/01/1988 - 12/24/1988
 PITTSBURGH CONSOLIDATION COAL CO. 11/23/1945 - 05/01/1988

LESSEE/OPERATOR
 EIGHTY FOUR MINE CO. 12/30/1992 - PRESENT
 BETHENERGY MINES, INC. 07/01/1987 - 12/30/1992

EIGHTY FOUR MINE COMPANY
 MINE #4
 P.O. BOX J
 CLATSVILLE, PA 15323

MSHA I.D. NO. 36-00958
 PA DEP OAM NO. 8381302
 SCALE 1" = 200'
 FINAL MINE MAP
 NOVEMBER 28, 2011

RELIEF/WATER MONITORING BOREHOLE
 HORIZONTAL & VERTICAL CONTROL
 STREAM
 IDENTIFIED GAS WELL
 ALLEGED WELL
 EXPLORATION CORE HOLE
 SEAL
 MINE PERMIT BOUNDARY
 NO KNOWN MINE WORKINGS UNDERLYING OR OVERLYING THE MINE PROPERTY
 MN SURVEY ACCURACY ±10,000 (CLOSED LOOP)

ALL BOREHOLES SEALED EXCEPT PRESSURE RELIEF/WATER MONITORING BOREHOLES.
 HALLAM POWER, HETATA VENTILATOR, KIRKBRIDGE, LIVINGSTON CONCRETE, LONG SHAFT BOREHOLE, RICHARDSON POWER, WEIR POWER, & ZEDKER POWER.

