


MATCH TO SHEET 203

MATCH TO SHEET 205

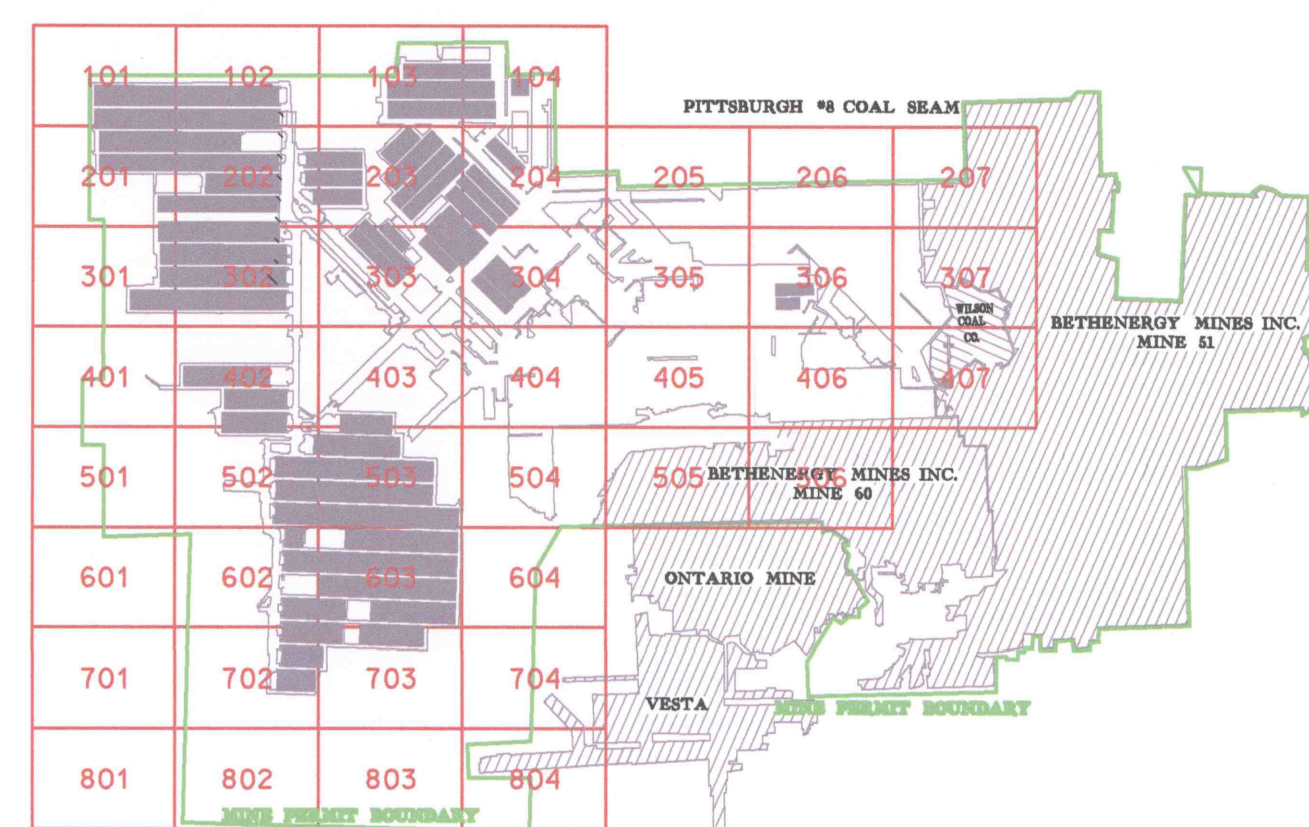

This map submitted in accordance with 30 CFR Sec. 75.1204 & PA Act 55 SB 949 Sec. 228 PERSONS PROVIDING INFORMATION ON MAP:
 MARK HOUTKAY, MINE FOREMAN
 NATHAN WOODS, MINE ENGINEER/TRANSE

INFORMATION INCORPORATED IN THIS MINE MAP WAS PROVIDED BY THE OPERATOR AND PREVIOUS OPERATORS AND MAY NOT HAVE ALL BEEN VERIFIED OR EVALUATED BY THE UNDERSIGNED. THE MAP MAY ALSO INCORPORATE THE SURVEY RESULTS AND MARKING PREPARED UNDER THE DIRECTION OF REGISTERED ENGINEERS OTHER THAN THE UNDERSIGNED. SUBJECT TO THE AFORESAID QUALIFICATIONS, TO THE BEST OF MY KNOWLEDGE AND BELIEF THIS DRAWING CONTAINS ACCURATE INFORMATION AND HAS BEEN COMPILED IN ACCORDANCE WITH GOOD ENGINEERING PRACTICES AS OF MARCH 19, 2008. MINE MAPS PREPARED BY STANDARDS ACCORDING TO PA DEP TPO NO. 583-2008-810 SEC. 22.8 PENNSYLVANIA STATE PLANE COORDINATE GRID (NAD83) DATUM.

CHAIN OF OWNERSHIP:
 OWNER/LESSOR
 RESERVE COAL PROPERTIES CO. 10/16/2001 - PRESENT
 LUCIFER LAND CO. 12/30/1992 - 10/16/2001
 BETHLEHEM STEEL CORP. 12/24/1968 - 12/30/1992
 CONSOLIDATION COAL CO. 05/01/1958 - 12/24/1968
 PITTSBURGH CONSOLIDATION COAL CO. 10/23/1945 - 05/01/1958

LESSEE/OPERATOR
 EIGHTY FOUR MINING CO. 12/30/1992 - PRESENT
 BETHENERGY MINES, INC. 07/01/1987 - 12/30/1992

EIGHTY FOUR MINING COMPANY
 MINE #4
 P.O. BOX 2
 CLAYSVILLE, PA 15333

MSHA I.D. NO. 34-00058
 PA DEP. CHAMP NO. 63051002
 SCALE 1" = 200'
 FINAL MINE MAP
 NOVEMBER 28, 2011

RELIEF/WATER MONITORING BOREHOLE
 HORIZONTAL & VERTICAL CONTROL
 STREAM
 IDENTIFIED GAS WELL
 ALLEGED WELL
 EXPLORATION CORE HOLE
 SEAL
 MINE PERMIT BOUNDARY
 UNKNOWN MINE WORKINGS UNDERLYING OR OVERLYING THE MINE PROPERTY
 MIN SURVEY ACCURACY +110,000 (CLOSED LOOP)

ALL BOREHOLES SEALED EXCEPT PRESSURE RELIEF/WATER MONITORING BOREHOLES
 HALLAM POWER, HUSTAVA VENTILATION, KISKIQUININE, LIVINGSTON CONCRETE, LONG SHAFT BOREHOLE,
 RICHARDSON POWER, WER POWER & ZEDKER POWER

