



MATCH TO SHEET 205

MATCH TO SHEET 207



MATCH TO SHEET 306

SHEET 206

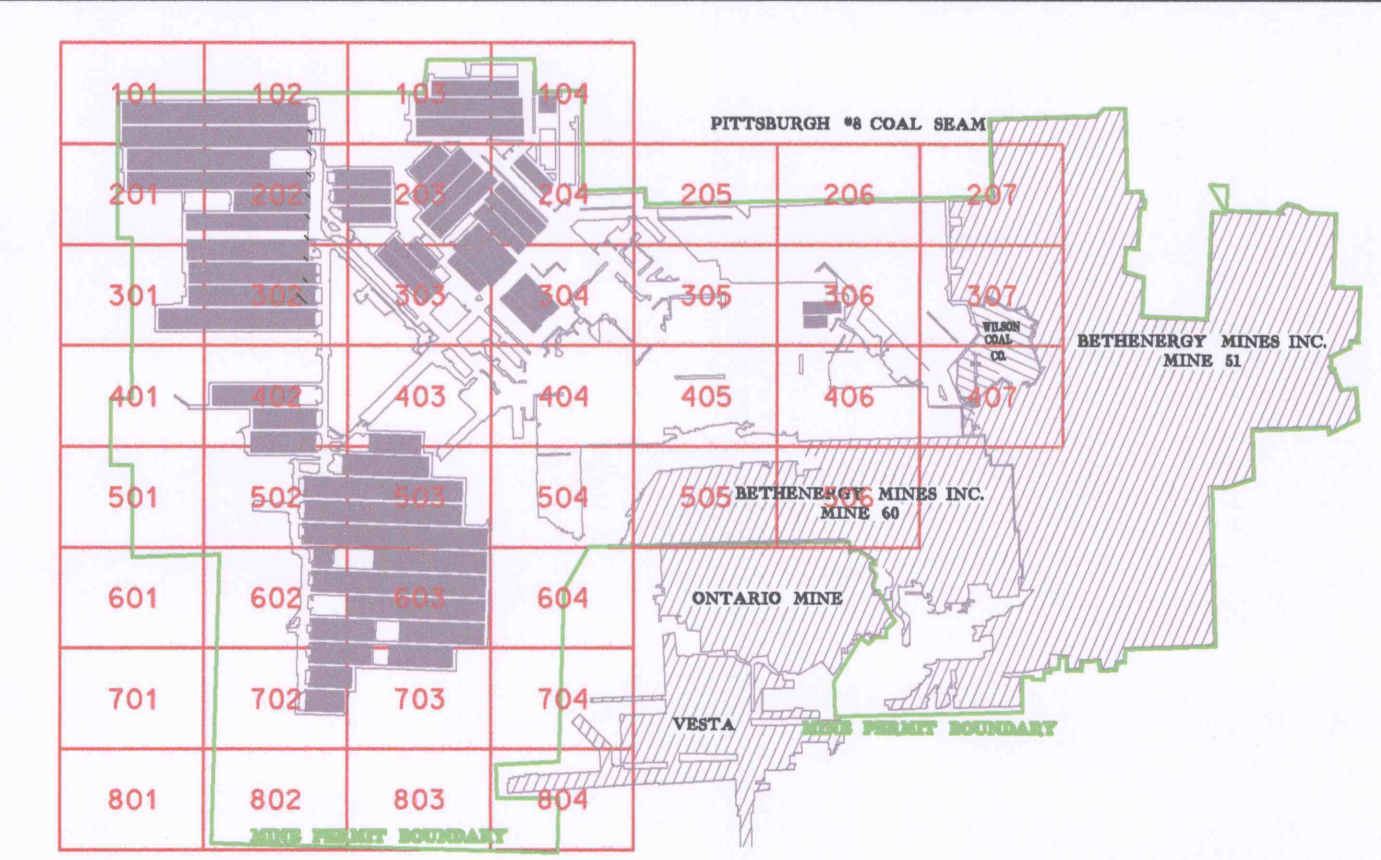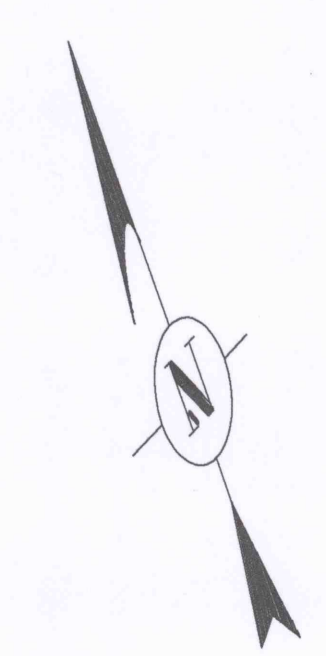

This map submitted in accordance with 30 CFR Sec. 75.1204 & PA Act 55 SB 949 Sec. 228
 PERSONS PROVIDING INFORMATION ON MAP:
 MARK HRETKIV, MINE FOREMAN
 NATHAN WOODS, MINE ENGINEER TRANESE

INFORMATION INCORPORATED IN THIS MINE MAP WAS PROVIDED BY THE OPERATOR AND PREVIOUS OPERATORS AND MAY NOT HAVE ALL BEEN VERIFIED OR EVALUATED BY THE UNDERSIGNED. THE MAP MAY ALSO INCORPORATE THE SURVEY RESULTS AND MAPPING PREPARED UNDER THE DIRECTION OF REGISTERED ENGINEERS OTHER THAN THE UNDERSIGNED, SUBJECT TO THE APPLICABLE QUALIFICATIONS, TO THE BEST OF MY KNOWLEDGE AND BELIEF, THIS DRAWING CONTAINS ACCURATE INFORMATION AND HAS BEEN COMPILED IN ACCORDANCE WITH GOOD ENGINEERING PRACTICES. AS OF MARCH 19, 2005, MINE MAPS PREPARED BY STANDARDS ACCORDING TO PA DEP 100 NO. 983-2004-910 SEC. 22.8 PENNSYLVANIA STATE PLANE COORDINATE GRID (NAD83 DATUM).

CHAIN OF OWNERSHIP:
 OWNER/LESSOR
 RESERVE COAL PROPERTIES CO. 11/16/2001 - PRESENT
 LUCERNE LAND CO. 12/30/1992 - 10/16/2001
 BETHELMEN STEEL CORP. 12/24/1988 - 12/30/1992
 CONSOLIDATION COAL CO. 05/01/1958 - 12/24/1988
 PITTSBURGH CONSOLIDATION COAL CO. 11/23/1845 - 05/01/1958

LESSEE/OPERATOR
 EIGHTY FOUR MINE CO. 12/30/1992 - PRESENT
 BETHENERY MINES, INC. 07/01/1987 - 12/30/1992

EIGHTY FOUR MINE COMPANY
 MINE 84
 P.O. BOX 1
 CLAYSVILLE, PA 15323

MEHA I.D. NO. 36-00098
 PA DEP CMAP NO. 83831502
 "SCALE" 1" = 200'
 FINAL MINE MAP
 NOVEMBER 25, 2011

RELIEF/WATER MONITORING BOREHOLE
 HORIZONTAL & VERTICAL CONTROL
 STREAM
 IDENTIFIED GAS WELL
 ALLEGED WELL
 EXPLORATION CORE HOLE
 SEAL
 MINE PERMIT BOUNDARY
 NO KNOWN MINE WORKINGS UNDERLYING OR OVERLYING THE MINE PROPERTY
 MN SURVEY ACCURACY +110,000 (CLOSED LOOP)

ALL BOREHOLES SEALED EXCEPT PRESSURE RELIEF/WATER MONITORING BOREHOLES (DALLAM POWER, HUSTAVA VENTILATION, KISHORINGUINE, LIVINGSTON CONCRETE, LONG SHAFT BOREHOLE, RICHARDSON POWER, NEER POWER, & ZENKER POWER)

